

HINDS MISSISSIPPI BOARD OF WATER COMMISSIONERS

R 7001


3-7-62

WATER WELL DRILLERS LOG

Date: Mar. 7, 1962, Driller: W. L. Butler County Smith

(Name)

	Description & Color of Materials Sand, Clay, Red Clay, Shell, etc.	Thick- ness Feet	Depth Feet
(1) Owner of Land: <u>William Baker</u> (Name) <u>Byram, Miss.</u> <u>Siwell Road</u> (Address)	Clay	1	8
(2) Location: <u>1/4, 1/4, Sec. 10 T. 4 R. 1 W.</u>	Rock	8	18
<u>2</u> miles <u>West</u> of <u>Byram</u> , (distance) (direction) (Nearest Town)	Chalk	13	30
(3) Topography: <input checked="" type="checkbox"/> (Hilly) <input type="checkbox"/> (Flat) <input type="checkbox"/> (Level)	Blue Gumbo	30	100
(4) Purpose of Well: <u>Domestic Home</u> (Domestic Irrigation Municipal, Industrial, Other)	Rock	103	140
	Sandy Chalk	120	160
	Mostly sand	160	178
	Licknite	178	180
	e sand	180	200
	Gumbo + sand	200	220
	Fine sand	220	242
Information upon completion of well:			
(1) Diameter <u>2</u> inches.			
(2) Total Depth <u>242</u> feet.			
(3) Water Level <u>60</u> feet below top of ground.			
(4) Cased to <u>168</u> , Size <u>2"</u>			
(5) Screen: Size <u>2</u> , Length <u>10'</u>			
(6) Were any formations sealed against pollution? <u>no</u>			
If YES depth of formation _____			
Why _____			
Drillers Remarks: _____			

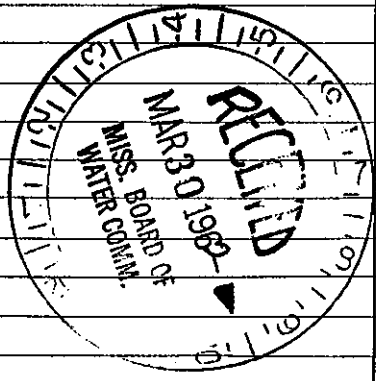

(Use Back Side)

Well No.

Mail this copy to Board of Water Commissioners 429 Miss. St. Jackson, Miss