

HINDS

MISSISSIPPI BOARD OF WATER COMMISSIONERS

R 2002

WATER WELL DRILLERS LOG

7-18-62

Date: 7-18, 1962, Driller: James McNeese County Hinds.

(Name)

(1) Owner of Land	Description & Color of Materials Sand, Clay, Red Clay, Shell, etc.	Thick- ness Feet	Depth Feet
AGNES JUANITA FERGUSON leased to Ray Carter BOUNDS ROAD (Name) (Address)	INC. SURFACE SOIL	15	15
(2) Location SE 1/4, NW 3/4, Sec. 7 A 1 E 2 1/2 miles south of Jackson (distance) (direction) (Nearest Town)	SAND	10	25
(3) Topography: <input checked="" type="checkbox"/> (Hilly) <input type="checkbox"/> (Flat) <input type="checkbox"/> (Level)	Grey shale-lignite	55	80
(4) Purpose of Well: Domestic Home (Domestic Irrigation Municipal, Industrial, Other)	SAND	2	82
	Grey shale sd strk's	53	135
	SAND FINE	20	155
	SAND Grey sh strk's	15	170
	SAND	15	185
	Grey-green sh	55	240

Information upon completion of well:


- (1) Diameter 4 inches. 2 40' hole
- (2) Total Depth 240 feet.
- (3) Water Level 30 feet below top of ground.
- (4) Cased to 175' 1 1/2" size 4"
- (5) Screen: Size 4" IPS, Length 10'
- (6) Were any formations sealed against pollution?
yes, no.

8 Jts 4"	168'
1 - 4"	7'
1-4" 007. stainless steel screen	175'
	10'
	185'
1-4" collar - B.P.V	
2nd 4" nipple	1'
	186'

If YES depth of formation

Why

Drillers Remarks:

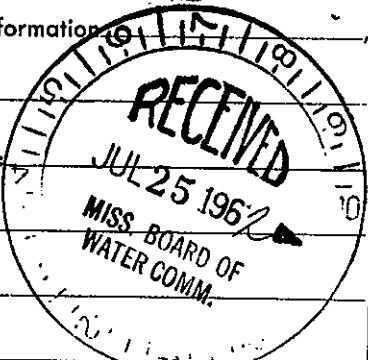

(Use Back Side)

Well No.

Mail this copy to Board of Water Commissioners 429 Miss. St. Jackson, Miss.