

HINDS
R 2085
10-62

MISSISSIPPI BOARD OF WATER COMMISSIONERS

WATER WELL DRILLERS LOG

Date: OCT, 1962, Driller: MENECE DRILLING Co County HINDS

(1) Owner of Land: MR ROY McLain
Box 192 (Name)
R.5 JACKSON MISS. (Address) 39212

(2) Location: SW 1/4, SE 1/4, Sec. 22, 4th 1/2 W
9 miles S of JACKSON
(distance) (direction) (Nearest Town)

(3) Topography: Hilly
(Hilly) (Flat) (Level)

(4) Purpose of Well: DOMESTIC Home
(Domestic Irrigation
Municipal, Industrial, Other)

(Name)

Description & Color of Materials Sand, Clay, Red Clay, Shell, etc.	Thick- ness Feet	Depth Feet
SURFACE Soil	3	3
WHITE SHALE	9	12
WHITE SAND	35	47
GREY SHALE	88	155
ROCK LEDGES	45	200
SHALE & SAND	15	215
COARSE SAND	15	230
SHALE & LIGNITE	73	303

Information upon completion of well:

(1) Diameter 4x2 inches. ^{1 1/2 in}

(2) Total Depth 230 feet. ³⁰³

(3) Water Level 95 feet below top of well
ground. ^{28' W}

(4) Cased to 215 feet. Size 4"
215' to 230' - 2"


(5) Screen: Size 2", Length 15'

(6) Were any formations sealed against pollution?
yes, X no.

If YES depth of formation

Why

Drillers Remarks:

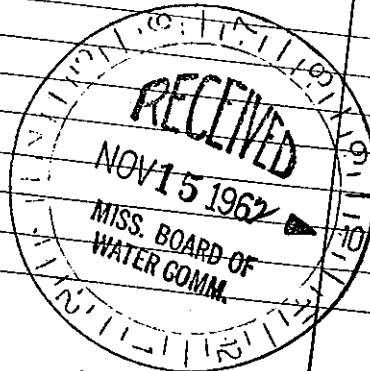

(Use Back Side)

Well No. 474

Mail this copy to Board of Water Commissioners 429 Miss. St. Jackson, Miss.