

HINDS
R 9806
11-62

MISSISSIPPI BOARD OF WATER COMMISSIONERS

WATER WELL DRILLERS LOG

Date: NOV, 1962, Driller: MENECE DRILLING Co. County HINDS

| | | Description & Color of Materials Sand, Clay, Red Clay, Shell, etc. | Thick- ness Feet | Depth Feet |
|--|--|---|------------------------|---------------|
| (1) Owner of Land: <u>C.A. ROOKER</u> (Name) | | <u>SURFACE SOIL</u> | <u>2</u> | <u>2</u> |
| <u>RED TERRY MISS.</u> (Address) | | <u>WHITE SAND</u> | <u>64</u> | <u>66</u> |
| (2) Location: <u>NW</u> $\frac{1}{4}$, <u>Sec. 28</u> $\frac{1}{4}$ <u>R1W</u> | | <u>GREY SHALE</u> | <u>22</u> | <u>88</u> |
| <u>4</u> miles <u>NW</u> of <u>TERRY</u> (distance) (direction) (Nearest Town) | | <u>SHALE & SAND</u> | <u>21</u> | <u>109</u> |
| (3) Topography: <u>Hilly</u> (Hilly) (Flat) (Level) | | <u>GREY SHALE</u> | <u>153</u> | <u>262</u> |
| (4) Purpose of Well: <u>DOMESTIC Home</u> (Domestic Irrigation Municipal, Industrial, Other) | | <u>ROCK LEDGES</u> | <u>50</u> | <u>312</u> |
| | | <u>SAND</u> | <u>25</u> | <u>337</u> |


Information upon completion of well:

- (1) Diameter 4x2 inches.
- (2) Total Depth 337 feet. ^{well}
- (3) Water Level 155 feet below top of ground. ³²⁷
- (4) Cased to 248, Size 4"
248'-337'-2" 2"
- (5) Screen: Size 10', Length 10'
- (6) Were any formations sealed against pollution?
_____ yes, X no.

If YES depth of formation _____

Why _____

Drillers Remarks: _____

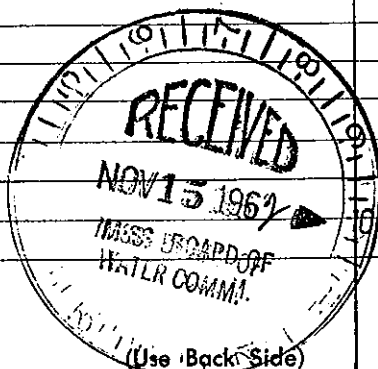

Well No. 79