


HINDS
R 2007
3-63

MISSISSIPPI BOARD OF WATER COMMISSIONERS

WATER WELL DRILLERS LOG

Date: MARCH, 1963, Driller: MCNEECE DRILLING Co., County: HINDS
(Name)

(1) Owner of Land: <u>HINDS CO. WATER CO.</u> (Name)	Description & Color of Materials Sand, Clay, Red Clay, Shell, etc.	Thick- ness Feet	Depth Feet
P.O. Box <u>8121</u> , <u>JACKSON MISS</u> (Address)	<u>SURFACE SOIL</u>	<u>4</u>	<u>4</u>
(2) Location: <u>SW 1/4, SW 1/4, Sec. 22 T. 4 N. R. 1 W.</u>	<u>WHITE SHALE</u>	<u>36</u>	<u>40</u>
<u>6</u> miles <u>N</u> of <u>TERRY</u> (distance) (direction) (Nearest Town)	<u>WHITE SAND</u>	<u>7</u>	<u>47</u>
(3) Topography: <u>HILLY</u> (Hilly) (Flat) (Level)	<u>GREY SHALE</u>	<u>123</u>	<u>170</u>
(4) Purpose of Well: <u>MUNICIPAL</u> (Domestic Irrigation Municipal, Industrial, Other)	<u>ROCK LEDGES</u>	<u>45</u>	<u>215</u>
Information upon completion of well:	<u>SHALE, LIGNITE + SAND</u>	<u>40</u>	<u>255</u>
(1) Diameter <u>4x2 1/2</u> inches.	<u>FINE SAND</u>	<u>3</u>	<u>258</u>
(2) Total Depth <u>1045</u> feet. ⁻¹⁴⁰⁵ Hole	<u>SHAKE + SAND</u>	<u>20</u>	<u>278</u>
(3) Water Level <u>196</u> feet below top of ground. ¹⁰⁴⁵ well	<u>SAND + LIGNITE</u>	<u>32</u>	<u>300</u>
(4) Cased to <u>400'</u> well, Size <u>4"</u>	<u>SAND</u>	<u>10</u>	<u>310</u>
(5) Screen: Size <u>2 1/2"</u> , Length <u>40'</u>	<u>GREY SHALE</u>	<u>435</u>	<u>745</u>
(6) Were any formations sealed against pollution? yes, <u>X</u> no.	<u>SAND, SHELL + SAND</u>	<u>30</u>	<u>775</u>
If YES depth of formation _____	<u>FINE SAND, SHALE + LIGNITE</u>	<u>179</u>	<u>954</u>
Why _____	<u>ROCK</u>	<u>5</u>	<u>959</u>
Drillers Remarks: _____	<u>SAND</u>	<u>86</u>	<u>1045</u>

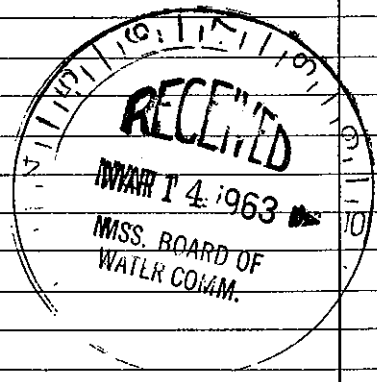

Well No. 48

(Use Back Side)

Mail this copy to Board of Water Commissioners 429 Miss. St. Jackson, Miss