

HINDS MISSISSIPPI BOARD OF WATER COMMISSIONERS


R 9810

12-1-64

WATER WELL DRILLERS LOG

Date: DEC 1, 1964, Driller: ELLI E HAY County HINDS  
HALL DRILLING CO

	Description & Color of Materials Sand, Clay, Red Clay, Shell, etc.	Thick- ness Feet	Depth Feet
(1) Owner of Land: <u>B.N. SPEAKE</u> <small>(Name)</small>	<u>SURFACE SOIL</u>	<u>4</u>	<u>4</u>
<u>RT 1 TERRY MISS</u> <small>(Address)</small>	<u>RED SAND</u>	<u>10</u>	<u>14</u>
(2) Location: <u>NE 1/4</u> , <u>1/4</u> , Sec. <u>29 T4 R1W</u>	<u>SHALE + LIGHT GREY SAND</u>	<u>6</u>	<u>20</u>
<u>7</u> miles <u>NE</u> , of <u>TERRY</u> <small>(distance) (direction) (Nearest Town)</small>	<u>BROWN SHALE + ROCK</u>	<u>128</u>	<u>148</u>
(3) Topography: <u>HILLY</u> <small>(Hilly) (Flat) (Level)</small>	<u>+ SAND STREAKS</u>	<u>40</u>	<u>188</u>
(4) Purpose of Well: <u>DOMESTIC Home</u> <small>(Domestic Irrigation Municipal, Industrial, Other)</small>	<u>HARD SHALE + ROCK</u>	<u>3</u>	<u>191</u>
Information upon completion of well:  (1) Diameter <u>7 1/2</u> inches. (2) Total Depth <u>399</u> <sup>well</sup> feet. (3) Water Level <u>136</u> feet below top of ground. (4) Cased to <u>2006.379</u> , Size <u>4"</u> <u>189</u> <u>2"</u> (5) Screen: Size <u>2"</u> , Length <u>20'</u> (6) Were any formations sealed against pollution? <u>no</u> , <u>X</u> <u>yes</u> . <u>379</u> <u>20</u> <u>399</u>  If YES depth of formation _____ Why _____ Drillers Remarks: _____	<u>SAND + SHALE</u>	<u>10</u>	<u>198</u>
	<u>HARD SHALE</u>	<u>72</u>	<u>270</u>
	<u>ROCK LEDGES</u>	<u>27</u>	<u>297</u>
	<u>SAND SEA SHELL + SHALE</u>	<u>11</u>	<u>308</u>
	<u>FINE SAND</u>	<u>20</u>	<u>328</u>
	<u>SAND + LIMITE</u>	<u>10</u>	<u>338</u>
	<u>SHALE</u>	<u>9</u>	<u>347</u>
	<u>MED GRAIN SAND</u>	<u>8</u>	<u>355</u>
	<u>SHALE</u>	<u>3</u>	<u>358</u>
	<u>FINE SAND</u>	<u>22</u>	<u>380</u>
<u>SHALE (HARD)</u>	<u>7</u>	<u>387</u>	
<u>MED GRAIN SAND</u>	<u>12</u>	<u>399+</u>	

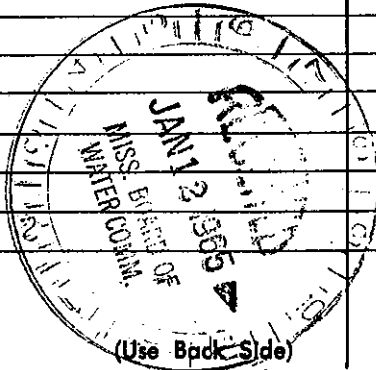

Well No. 7

Mail this copy to Board of Water Commissioners 429 Miss. St. Jackson, Miss.