

HINDS MISSISSIPPI BOARD OF WATER COMMISSIONERS

R 771


6-18-65

WATER WELL DRILLERS LOG

Date: JUNE 18, 1965, Driller: HALL DRILLING CO County HINDS

(Name)

(1) Owner of Land	Description & Color of Materials Sand, Clay, Red Clay, Shell, etc.	Thick- ness Feet	Depth Feet
BROOKWOOD COUNTRY CLUB G.Y. GUESS	SURFACE SOIL	4	4
(Address)	PINK SANDY CLAY	16	20
(2) Location: <u>S 1/4, NE 1/4, Sec. 33 TANRIM</u>	GREY SHALE	21	41
<u>1/4</u> miles <u>N.W.</u> , of <u>WINDALL</u>	ROCK LEDGES	50	90
(distance) (direction) (Nearest Town)	BLUE SHALE	40	130
(3) Topography: <u>HILLY</u>	ROCK + SAND	22	152
(Hilly) (Flat) (Level)	SHALE	90	240
(4) Purpose of Well: <u>DOMESTIC HOME</u>	ROCK LEDGES	71	281
(Domestic Irrigation Municipal, Industrial, Other)	SAND + SEA SHELL	15	296
Information upon completion of well:	SAND +	14	310
(1) Diameter <u>4 X 2</u> inches.	SAND + SHALE + L.I.C.	44	354
(2) Total Depth <u>421</u> ^{Hole} feet.	SAND	10	364
(3) Water Level <u>135</u> feet below top of ground.	SAND + SHALE + L.I.C.	57	421
(4) Cased to <u>421</u> ⁴⁰¹ ^{230' 4"} ^{171-2'} Size			
(5) Screen: Size <u>2</u> , Length <u>20</u>			
(6) Were any formations sealed against pollution?			
yes, <u>X</u> no.			
If YES depth of formation <u>230</u>			
Why			
Drillers Remarks:			

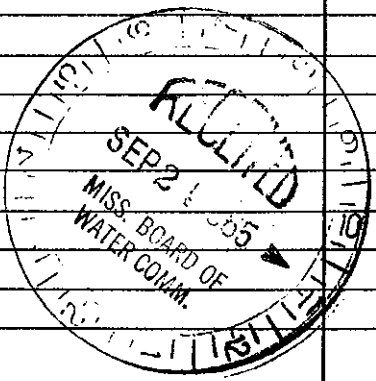

Well No.
15

(Use Back Side)

Mail this copy to Board of Water Commissioners 429 Miss. St. Jackson, Miss.