

Hinds
R 2014
9-66

MISSISSIPPI BOARD OF WATER COMMISSIONERS

WATER WELL DRILLERS LOG

Date: 9-5, 1966, Driller: HALL DRILLING CO County HINDS

(Name)

(1) Owner of Land: E.D. HUFF
(Name)
RI. JACKSON
(Address)

(2) Location: SW 1/4, SW 1/4, Sec. 3 T4R1W
9 miles SW of JACKSON
(distance) (direction) (Nearest Town)

(3) Topography: FLAT
(Hilly) (Flat) (Level)

(4) Purpose of Well: DOMESTIC Home
(Domestic Irrigation, Municipal, Industrial, Other)

Description & Color of Materials Sand, Clay, Red Clay, Shell, etc.	Thick- ness Feet	Depth Feet
SURFACE SOIL	4	4
YELLOW MARL	8	12
WHITE SAND	3	15
BLACK SH + SAND	16	31
SANDY BROWN SHALE	31	62
HARD BROWN SHALE	32	94
ROCK LEDGES	45	139
SAND + SEA SHELL	10	149
GREY SHALE	11	160
FINE SAND + SHALE	95	255
YAZOO CLAY	445	700
MOODY BRANCH	15	715
HARD SHALE	21	736
SAND + SHALE	18	754
SHALE	20	770
COURSE SAND / SHALE	27	797
FINE SAND + LIGNITE	50	847
FINE SAND	20	867
MED SAND	40	907
COURSE SAND	62	969
SHALE	2	971

Information upon completion of well:

(1) Diameter: 7 x 2 1/2 inches.

(2) Total Depth: 971 feet.

(3) Water Level: 168 feet below top of ground.

(4) Cased to 900' 931', Size 4" 2 1/2"


(5) Screen: Size 2 1/2", Length 40'

(6) Were any formations sealed against pollution?
 yes, no. 931
+40
971 well

If YES depth of formation _____

Why _____

Drillers Remarks: _____

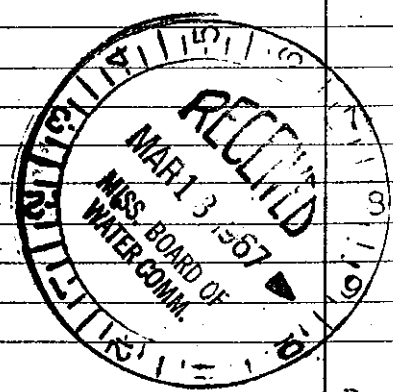

35 Well No.

(Use Back Side)