

91

County: Hinds  
 Permit #: \_\_\_\_\_  
 Driller: John W Thompson  
 Date drilling completed: 5-15-17

# STATE WELL REPORT

## Part 1

**Driller's Log**  
 Mississippi Department of Environmental Quality  
 Office of Land and Water Resources  
 P.O. Box 2309  
 Jackson, MS 39225-2309  
 (601)961-5210  
 (601)360-0535 (fax)

**For Office Use Only:**  
 Well #: 567  
 Aquifer: \_\_\_\_\_  
 E-Log #: \_\_\_\_\_

**RECEIVED**  
**MAY 30 2017**  
**BY OLWR**

*State Law requires that this report be prepared by the license holder responsible for the work and filed with the Department at the above address within 30 days of completion of drilling of the well or borehole.*

Well Owner Information <i>(Landowner if borehole is not for a water well)</i>			Well or Borehole Location	
Owner Name: <u>Reedtown Water Association</u>			Latitude: <u>32° 3' 51.3"</u> Longitude: <u>90° 38' 21.8"</u>	
Mailing Address: _____			Method of Lat/Long (check one): Conventional Survey _____	
_____			USGS quad _____, Hand-held GPS _____, Survey-grade GPS _____	
City _____ State _____ Zip Code _____			<u>NE</u> ¼ <u>NE</u> ¼, Sec <u>31</u> T <u>3N</u> R <u>4W</u>	
Telephone No. (____) _____			<u>2.5</u> Miles <u>S</u> of <u>Utica</u>	
			(Distance) (Direction) (Nearest Town)	

**Well / Borehole Data**

Date drilling started: 5-3-17 Date drilling completed: 5-15-17 Hole depth: 180 Hole diameter: 11

Location of the source of any surface water used for drilling: City water

Method of dosing and volume of Chlorine used in drilling and development: \_\_\_\_\_

Logs run (circle all applicable): No log run  Electric  Gamma Ray  Density  Sonic  Neutron  Other: \_\_\_\_\_

Name of organization running log(s): \_\_\_\_\_

Purpose of borehole (circle one):  Water Well  Geotechnical/Geological Investigation  Ground Source Heat Pump  
 Seismic Survey  Other (describe): \_\_\_\_\_

*If drilling is not related to water well construction, skip the remainder of this block*

Purpose of Well (circle all applicable): Home  Industrial  Public Supply  Irrigation  Fish Culture

Other (describe): Test well #2 Pa A 5/15/17

If a flowing well, method of flow regulation: Valve \_\_\_\_\_ Other (describe) \_\_\_\_\_

Static Water Level: 106 feet [above or below] land surface Date measured: \_\_\_\_\_  
(circle one)

Method of measurement (circle one):  Steel tape  Electric tape  Air line  Other (describe): \_\_\_\_\_

Well depth: 180 Well grouted to a depth of: \_\_\_\_\_ feet Type of grout (circle one): Neat Cement  Bentonite  Mix

Casing length: 160 feet Casing diameter: 7 inches Type of casing: steel

Screen length: 20 feet Screen diameter: 6 inches Type of screen: Stainless

Screen slot size: 020 inches Setting depth: From 160 feet to 180 feet

Type of completion (circle all applicable): Gravel packed  Underreamed  Open hole   Natural Development

Other (describe): \_\_\_\_\_

Top of lap pipe or reduction in casing: \_\_\_\_\_ feet

*If telescoped or more than one screen, describe on next page*



# STATE WELL REPORT

## Part 2

**Pump Installer's Completion Report**  
 Mississippi Department of Environmental Quality  
 Office of Land and Water Resources  
 P.O. Box 2309  
 Jackson, MS 39225-2309  
 (601)961-5210  
 (601) 360-0535 (fax)

County: Hinds  
 Permit #: \_\_\_\_\_  
 Driller: John W Thompson  
 Date completed: 5-15-17  
Copy information from block on Part 1

**For Office Use Only:**  
 Well #: \_\_\_\_\_  
 Aquifer: \_\_\_\_\_

*This part of the report must be completed by a licensed water well contractor or a licensed pump installer. A copy of Part 1 of the report must be attached and both parts filed with the Department at the above address within 30 days of well completion.*

Well Owner Information	Well Location
Owner Name: <u>Reedtown Water Association</u>	Latitude: <u>32° 3' 57.3"</u> Longitude: <u>90° 38' 21.8"</u>
Mailing Address: _____	Method of Lat/Long (check one): Conventional Survey _____, USGS quad _____, Hand-held GPS _____, Survey-grade GPS _____
City _____ State _____ Zip Code _____	_____ 1/4 _____ 1/4, Sec <u>31</u> T <u>3N</u> R <u>4W</u>
Telephone No. (____) _____	<u>2.5</u> Miles <u>S</u> of <u>Utica</u> (Distance) (Direction) (Nearest Town)

**Pump Type (circle one)**

Submersible  Turbine  Air Lift  Centrifugal  Flowing Well  Jet  Piston  Rotary  Other (describe): \_\_\_\_\_

Date Pump Installed: 5-8-17 Rated Pump Capacity: 85 Gallons Per Minute

Is This Pump (circle one):  New  Repaired  Replacement

**Power Type (circle one)**

Electric  Diesel  Gasoline  Natural Gas  Tractor PTO  Windmill  Other (describe): \_\_\_\_\_

Horse Power Rating of Motor: 5 Setting Depth: 160 feet Number of Stages: \_\_\_\_\_

**Pump Test Data for Non Flowing Well**

Date Well Tested: 5-8-17 Duration of Pump Test (minimum 4 hours): \_\_\_\_\_ hours

Static Water Level (A): 106 Feet Below Land Surface Pumping Water Level (B): 160 Feet Below Land Surface

Drawdown [(B) - (A)]: 54 Feet Below Land Surface Test Pumping Rate: 13 Gallons Per Minute

Method of measurement (circle one): Steel tape  Electric tape  Air line  Other (describe): \_\_\_\_\_

**Pump Test Data for Flowing Well**

Measured shut in head: \_\_\_\_\_ feet.

Well yielded \_\_\_\_\_ GPM with a drawdown of \_\_\_\_\_ feet after \_\_\_\_\_ hours of pumping

**Meter Installation**

Meter Manufacturer: \_\_\_\_\_ Meter Serial Number: \_\_\_\_\_

Meter Model Number/Name: \_\_\_\_\_ Type of Meter: \_\_\_\_\_

Totalizer Register Unit and Multiplier Factor (AF x .001, gal x 1000, etc): \_\_\_\_\_

Installation Date: \_\_\_\_\_ Meter installed by: \_\_\_\_\_

Is This Meter (circle one):  New  Repaired  Replacement

**Important:** By submitting the above information you are certifying that this meter was installed to manufacturer standards. For agricultural wells, a list of approved meters is on the MDEQ website.

I HEREBY CERTIFY that the above statements are true to the best of my knowledge.

John W Thompson 0-679 5-30-17 John W Thompson  
 Print Name of Pump Installer and License No. (if applicable) Date Signature of Pump Installer

RECEIVED  
MAY 30 2017  
BY OLWR

Google Maps 32°03'51.3"N 90°38'21.8"W




Imagery ©2017 DigitalGlobe, Landsat / Copernicus, USDA Farm Service Agency, Map data ©2017 Google 2000 ft

RECEIVED  
MAY 30 2017  
BY OLIVIA R.



[https://www.google.com/maps/place/32°03'51.3\"N+90°38'21.8\"W/@32.066623,-90.6483582,7683m/data=!3m1!1e3!4m5!3m4!1s0x0:0x0:018m2!3d32.06425!4d-90.6393889](https://www.google.com/maps/place/32°03'51.3\)

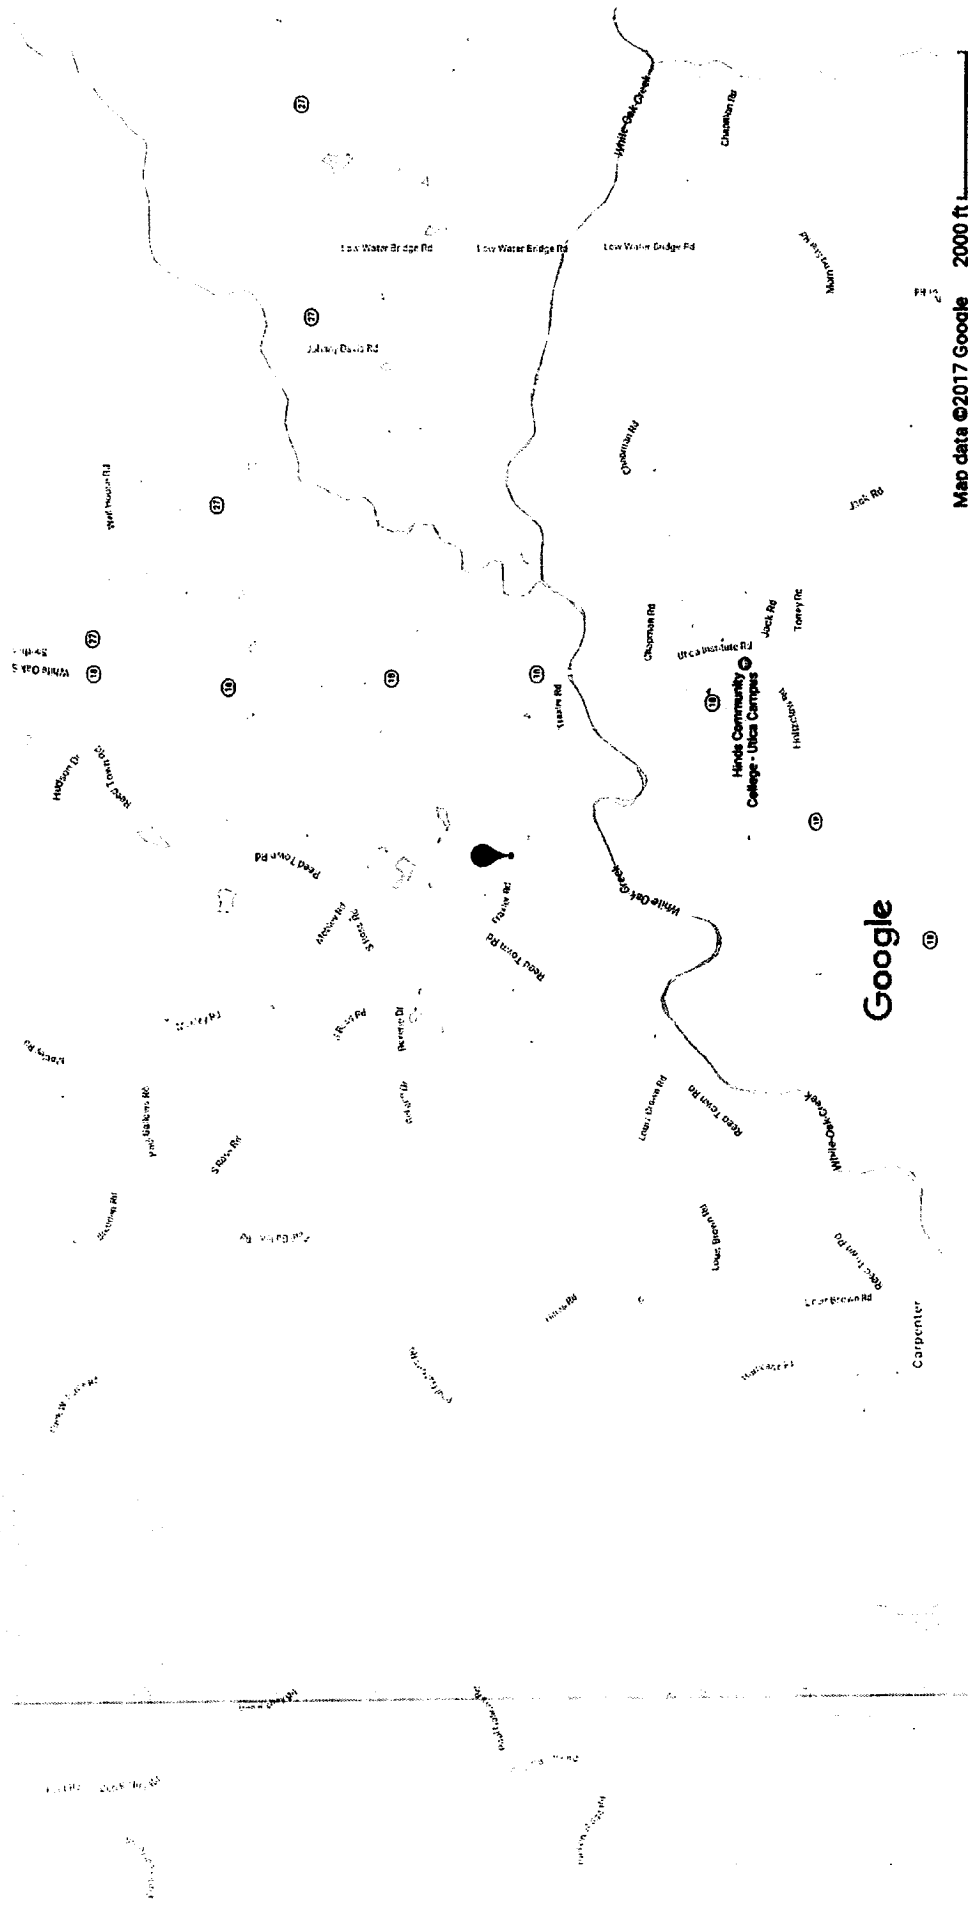

Map data ©2017 Google 2000 ft

Google

RECEIVED  
 MAY 30 2017  
 BY OLNR

RECEIVED

MAY 30 2017

BY OLWR