

HINDS MISSISSIPPI BOARD OF WATER COMMISSIONERS Petrich

S 2004
4-25-62

WATER WELL DRILLERS LOG, ~~Petrich~~

Date: 4-26 '62 Driller: Petrich County: Hinds
(Name)

(1) Owner of Land: Gene Neill
(Name)

Utin Miss
(Address)

(2) Location: 1/4, 1/4, Sec. T31R4W

6 miles west of Utin
(distance) (direction) (Nearest Town)

(3) Topography: Hilly
(Hilly) (Flat) (Level)

(4) Purpose of Well: Home
(Domestic Irrigation
Municipal, Industrial, Other)

Description & Color of Materials
Sand, Clay, Red Clay, Shell, etc.

Thick-
ness
Feet

Depth
Feet

0-70 Red Clay
70-43 sand gravel
43-149 white clay
149-166 white gravel

Information upon completion of well:

(1) Diameter 2 inches.

(2) Total Depth 166 feet. $\frac{166}{161}$

(3) Water Level 114 feet below top of ground.

(4) Cased to 166 (Size 2)


(5) Screen: Size 2, Length 5

(6) Were any formations sealed against pollution?
_____ yes, _____ no.

If YES depth of formation _____

Why _____

Drillers Remarks: _____

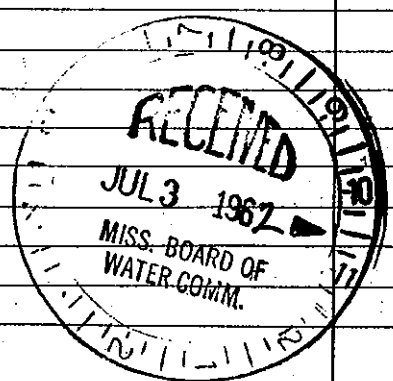

Well No.

(Use Back Side)

Mail this copy to Board of Water Commissioners 429 Miss. St. Jackson, Miss.