

HINDS MISSISSIPPI BOARD OF WATER COMMISSIONERS

S 2005

9-63

WATER WELL DRILLERS LOG

(R.G.)

Date: SEPT, 1963, Driller: McNEECE DRILLING Co County HINDS

(Name)

(1) Owner of Land: MR LAUELLE BROWN
(Name)
WTICA MISS
(Address)

(2) Location: 1/4, NW 1/4, Sec. 1 T3N R4W
3 miles E of WTICA
(distance) (direction) (Nearest Town)

(3) Topography: HILLY
(Hilly) (Flat) (Level)

(4) Purpose of Well: DOMESTIC HOV
(Domestic Irrigation
Municipal, Industrial, Other)

| Description & Color of Materials Sand, Clay, Red Clay, Shell, etc. | Thick- ness Feet | Depth Feet |
|---|------------------------|---------------|
| SURFACE SOIL | 8 | 8 |
| WHITE SHALE | 24 | 32 |
| GREY SHALE | 42 | 74 |
| FINE SAND + SHALE | 34 | 108 |
| SHALE | 42 | 150 |
| SHALE + SAND | 12 | 162 |
| ROCK LEDGES | 32 | 194 |
| SHALE | 22 | 216 |
| SHALE + SAND | 21 | 237 |
| SHALE | 31 | 268 |
| ROCK + SHALE | 23 | 291 |
| SHALE | 21 | 312 |
| ROCK + SHALE + SAND | 15 | 327 |
| SAND + SHALE | 12 | 339 |
| SHALE | 13 | 352 |
| SAND + SHALE | 7 | 359 |
| FINE SAND | 14 | 373 |
| COARSE SAND | 27 | 400 |
| SHALE | 8 | 408 |

Information upon completion of well:

(1) Diameter 4x2 inches.

(2) Total Depth 408 ^{hole} feet.

(3) Water Level 84 feet below top of ground. ³⁸⁸

(4) Cased to 270', Size 4"
270' - 408' - 2"


(5) Screen: Size 2", Length 20'

(6) Were any formations sealed against pollution?
yes, X no.

If YES depth of formation _____

Why _____

Drillers Remarks: _____

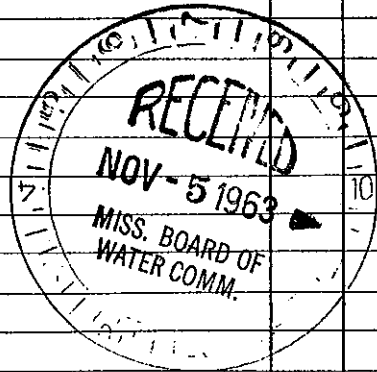

Well No. 69

(Use Back Side)

Mail this copy to Board of Water Commissioners 429 Miss. St. Jackson, Miss.