


HINDS MISSISSIPPI BOARD OF WATER COMMISSIONERS

S 2006
9-12-63

WATER WELL DRILLERS LOG

Date: 9-12-63, 19 63, Driller: Burney Water Well Serv County Hinds
(Name)

| (1) Owner of Land: <u>Kent Strong</u> (Name) | Description & Color of Materials Sand, Clay, Red Clay, Shell, etc. | Thick- ness Feet | Depth Feet |
|--|---|------------------------|---------------|
| <u>Utica, Miss.</u> (Address) | <u>Red top soil</u> | <u>0</u> | <u>20</u> |
| (2) Location: <u>3/4</u> , <u>3/4</u> , Sec. <u>T 31 R 4</u> | <u>Sandy gravel</u> | <u>3</u> | <u>23</u> |
| <u>3</u> miles <u>SW</u> of <u>Utica</u> (distance) (direction) (Nearest Town) | <u>White pipe clay</u> | <u>13</u> | <u>36</u> |
| (3) Topography: <u>Hilly</u> (Hilly) (Flat) (Level) | <u>Blue clay</u> | <u>16</u> | <u>52</u> |
| (4) Purpose of Well: <u>Domestic Home</u> (Domestic Irrigation Municipal, Industrial, Other) | <u>Fine sand layers</u> | <u>4</u> | <u>56</u> |
| Information upon completion of well: | <u>All med. sand</u> | <u>10</u> | <u>66</u> |
| (1) Diameter <u>6</u> inches. | <u>Hard blue shale</u> | <u>3</u> | <u>69</u> |
| (2) Total Depth <u>218</u> feet. | <u>Hard rock</u> | <u>8</u> | <u>77</u> |
| (3) Water Level <u>51</u> feet below top of ground. | <u>Blue clay</u> | <u>26</u> | <u>103</u> |
| (4) Cased to <u>210'</u> , Size <u>4"</u> | <u>Sand layers</u> | <u>4</u> | <u>107</u> |
| (5) Screen: Size <u>2 1/2"</u> , Length <u>5'</u> | <u>Hard shale</u> | <u>19</u> | <u>126</u> |
| (6) Were any formations sealed against pollution? <u>X</u> yes, <u> </u> no. | <u>Sand layers</u> | <u>4</u> | <u>130</u> |
| If YES depth of formation <u>From surface</u> | <u>Black shale</u> | <u>9</u> | <u>139</u> |
| Why <u>to prevent surface pollution</u> | <u>Rock layers</u> | <u>13</u> | <u>152</u> |
| Drillers Remarks: | <u>Rock</u> | <u>2</u> | <u>154</u> |
| | <u>Hard shale</u> | <u>18</u> | <u>172</u> |
| | <u>Sand layers</u> | <u>16</u> | <u>188</u> |
| | <u>All sand</u> | <u>30</u> | <u>218</u> |

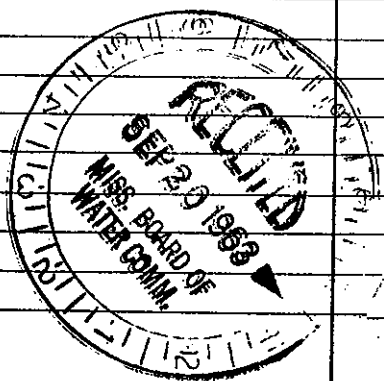

(Use Back Side)

Mail this copy to Board of Water Commissioners 429 Miss. St. Jackson, M