

HINDS

MISSISSIPPI BOARD OF WATER COMMISSIONERS

S 2887

10-63


WATER WELL DRILLERS LOG

(R.G.)

Date: OCT, 1963, Driller: MCNEECE DRILLING County HINDS

(Name CO

(1) Owner of Land: <u>W. G. HALL</u> (Name)	Description & Color of Materials Sand, Clay, Red Clay, Shell, etc.	Thick- ness Feet	Depth Feet
<u>RT 1, RAYMOND MISS.</u> (Address)	SURFACE SOIL	8	8
(2) Location: <u>1/4 SW 1/4, Sec. 31 T<sup>4N</sup> R<sup>3W</sup></u>	YELLOW SHALE	8	16
<u>4</u> miles <u>E</u> of <u>WITICA</u> (distance) (direction) (Nearest Town)	GRAVEL	2	18
(3) Topography: <u>HILLY</u> (Hilly) (Flat) (Level)	WHITE SHALE	26	44
(4) Purpose of Well: <u>DOMESTIC Home</u> (Domestic Irrigation Municipal, Industrial, Other)	WHITE SAND	10	54
Information upon completion of well:	SHALE + ROCK	55	109
(1) Diameter <u>4x2</u> inches.	SHALE	163	272
(2) Total Depth <u>427</u> feet. <sup>Home</sup> $\frac{427}{15} = 412$	ROCK LEDGES	57	329
(3) Water Level <u>100</u> feet below top of ground. <sup>412</sup>	SHELL + SAND	17	346
(4) Cased to <u>260'</u> , Size <u>4"</u> <u>260' - 427' - 2"</u>	SHALE	20	366
(5) Screen: Size <u>2"</u> , Length <u>15'</u>	SHALE	13	379
(6) Were any formations sealed against pollution? <u>no</u>	FINE SAND	9	388
If YES depth of formation _____	SHALE	12	400
Why _____	SAND	10	410
Drillers Remarks: _____	SHALE	4	414
_____	SAND	8	422
_____	SHALE	5	427
_____	SHALE		
_____	SHALE		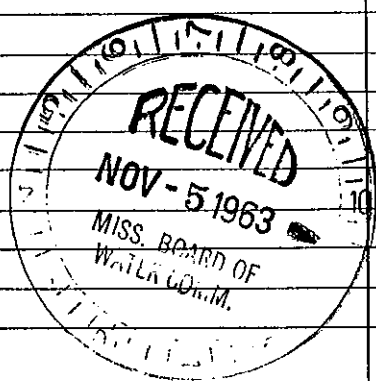
(Use Back Side)

Well No. 61

Mail this copy to Board of Water Commissioners 429 Miss. St. Jackson, Miss.