

HINDS MISSISSIPPI BOARD OF WATER COMMISSIONERS


S 2009
4-6-64

WATER WELL DRILLERS LOG

Date: April 6, 1964, Driller: Burney Water Well Service County Hinds

(Name)

(1) Owner of Land: Bill T. Herren (Name) Route 2, Utica, Miss. (Address)	Description & Color of Materials Sand, Clay, Red Clay, Shell, etc.	Thick- ness Feet	Depth Feet
	Yellow top soil	18	18
	Gravel & sand	7	25
(2) Location: <u>2 1/2 miles West of Utica</u> (distance) (direction) (Nearest Town)	Gray clay	11	36
	Quick sand	4	40
	Blue clay & shale	5	45
	Hard gray shale	30	75
(3) Topography: <u>Hilly</u> (Hilly) (Flat) (Level)	Fine sand layers	9	84
	All fine sand	6	90
(4) Purpose of Well: <u>Domestic Home</u> (Domestic Irrigation Municipal, Industrial, Other)	Clay	3	93
	All fine sand	4	97
	Hard shale	5	102
	Rock & shale	2	104
Information upon completion of well:			
(1) Diameter <u>4</u> inches.			
(2) Total Depth <u>104</u> feet.			
(3) Water Level <u>42</u> feet below top of ground.			
(4) Cased to <u>82'</u> <u>87'</u> well, Size <u>2"</u>			
(5) Screen: Size <u>2 1/2"</u> , Length <u>5'</u>			
(6) Were any formations sealed against pollution?			
<u>X</u> yes, <u> </u> no.			
If YES depth of formation <u>From surface</u>			
Why <u>to prevent surface pollution</u>			
Drillers Remarks:			

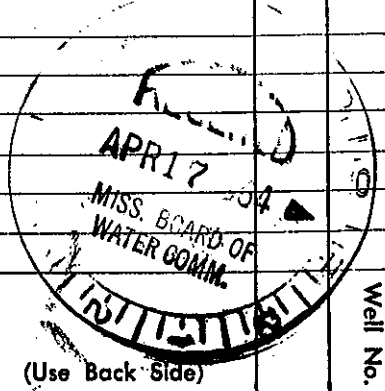

Well No.

(Use Back Side)

Mail this copy to Board of Water Commissioners 429 Miss. St. Jackson, Miss