

HINDS MISSISSIPPI BOARD OF WATER COMMISSIONERS

S 2010
10-30-64

WATER WELL DRILLERS LOG

Date: OCT 30, 1964, Driller: ELI C HALL County HINDS
HALL DRILLING CO

	Description & Color of Materials Sand, Clay, Red Clay, Shell, etc.	Thick- ness Feet	Depth Feet
(1) Owner of Land: <u>M M DAVIS</u> (Name) <u>130 SHADOWLAWN DR</u> <u>JACKSON MISS</u>	<u>SURFACE SOIL</u>	<u>5</u>	<u>5</u>
(2) Location: <u>E 1/4, NE 1/4, Sec. 34 T24N R2W</u> <u>5</u> miles <u>SW</u> of <u>UTICA</u> (distance) (direction) (Nearest Town)	<u>BROWN CLAY</u>	<u>15</u>	<u>20</u>
(3) Topography: <u>FLAT</u> (Hilly) (Flat) (Level)	<u>WHITE SAND + ROCK</u>	<u>-</u>	<u>-</u>
(4) Purpose of Well: <u>DOMESTIC</u> Home (Domestic Irrigation Municipal, Industrial, Other)	<u>+ SHALE</u>	<u>66</u>	<u>86</u>
	<u>FINE BLACK SAND</u>	<u>21</u>	<u>107</u>
	<u>ROCK + DARK GREY SAND</u>	<u>43</u>	<u>150</u>
	<u>SAND + SHALE + LIGNITE</u>	<u>74</u>	<u>224</u>
	<u>COURSE SAND</u>	<u>28</u>	<u>252</u>
	<u>SHALE</u>	<u>5</u>	<u>257</u>

Information upon completion of well:

(1) Diameter 4 X 2 inches.

(2) Total Depth 257 feet. ^{140' C} ₂₅₇ ¹¹⁰ ₂₄₇

(3) Water Level 62 feet below top of ground. ^{247' well}

(4) Cased to 195, Size 4"
247 52 2"


(5) Screen Size 2", Length 10'

(6) Were any formations sealed against pollution?
yes, X no.

If YES depth of formation _____

Why _____

Drillers Remarks: _____

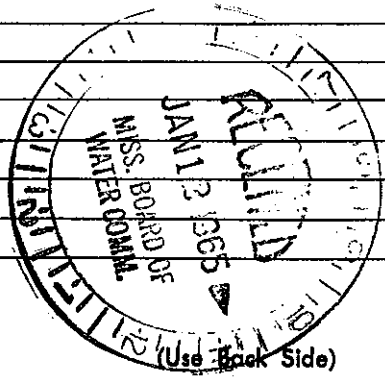

Well No.
3

Mail this copy to Board of Water Commissioners 429 Miss. St. Jackson, Miss.