


HINDS MISSISSIPPI BOARD OF WATER COMMISSIONERS

S 2013
4-21-66

WATER WELL DRILLERS LOG

Date: April 21, 1966, Driller: E B FORE County Hinds
(Name)

		Description & Color of Materials Sand, Clay, Red Clay, Shell, etc.	Thick- ness Feet	Depth Feet
(1) Owner of Land: <u>WC Harris</u> (Name) <u>LEARNED MISS</u> (Address)		<u>Brown Shy Cl</u>	<u>0</u>	<u>10</u>
(2) Location: <u>3/4</u> , <u>4/4</u> Sec. <u>T 31 N 40 W</u>		<u>Light Blue Cl</u>	<u>10</u>	<u>13</u>
<u>4</u> miles <u>EAST</u> of <u>Utica</u> (distance) (direction) (Nearest Town)		<u>Light Blue Shy</u>	<u>13</u>	<u>20</u>
(3) Topography: <u>Hilly</u> (Hilly) (Flat) (Level)		<u>Shy Cl & Sand</u>	<u>20</u>	<u>30</u>
(4) Purpose of Well: <u>Domestic Home</u> (Domestic Irrigation, Municipal, Industrial, Other)		<u>Light Blue Cl</u>	<u>31</u>	<u>33</u>
Information upon completion of well:		<u>Brown Cl</u>	<u>33</u>	<u>35</u>
(1) Diameter: <u>4 1/4</u> inches. ^{HS 120}		<u>Blue Cl</u>	<u>35</u>	<u>40</u>
(2) Total Depth: <u>84</u> feet. ^{24 well}		<u>Bl Cl Hard</u>	<u>40</u>	<u>50</u>
(3) Water Level: <u>54</u> feet below top of ground.		<u>Blue Cl</u>	<u>50</u>	<u>60</u>
(4) Cased to: <u>84</u> feet. ^{Cast} Size		<u>Blue Clay</u>	<u>60</u>	<u>70</u>
(5) Screen: Size <u>20</u> , Length <u>5'</u>		<u>M. Cl</u>	<u>70</u>	<u>73</u>
(6) Were any formations sealed against pollution? yes, <u>No</u> no.		<u>Soft. Sh. - fine</u>	<u>73</u>	<u>78</u>
If YES depth of formation _____		<u>Sol.</u>	<u>78</u>	<u>83</u>
Why _____		<u>Cl Blue</u>	<u>83</u>	<u>90</u>
Drillers Remarks: _____		<u>Cl Blue</u>	<u>90</u>	<u>100</u>
		<u>Bl Cl</u>	<u>100</u>	<u>110</u>
		<u>Bl Cl</u>	<u>110</u>	<u>120</u>

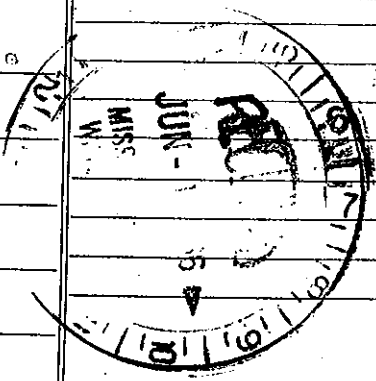

(Use Back Side)

Well No.

Mail this copy to Board of Water Commissioners 429 Miss. St. Jackson, Miss.