

HINDS  
5 2014

MISSISSIPPI BOARD OF WATER COMMISSIONERS

7-66

WATER WELL DRILLERS LOG

Date: 7-29, 1966, Driller: HALL DRILLING CO County HINDS  
(Name)

(1) Owner of Land: <u>CHARLES WILLIAMS</u> (Name)	Description & Color of Materials Sand, Clay, Red Clay, Shell, etc.	Thick- ness Feet	Depth Feet
<u>RT 1 BOX 214 UTICA MISS</u> (Address)	<u>SURFACE SOIL</u>	<u>4</u>	<u>4</u>
(2) Location: <u>NE 1/4, SW 1/4, Sec. 33 T8 R4W</u> <u>3/4</u> miles <u>SOUTH</u> , of <u>UTICA</u> (distance) (direction) (Nearest Town)	<u>GREY MARL</u>	<u>16</u>	<u>20</u>
(3) Topography: <u>FLAT</u> (Hilly) (Flat) (Level)	<u>WHITE SAND</u>	<u>41</u>	<u>61</u>
(4) Purpose of Well: <u>DOMESTIC HOME</u> (Domestic Irrigation Municipal, Industrial, Other)	<u>BLUE SHALE + SAND</u>	<u>20</u>	<u>81</u>
	<u>BLUE SHALE + ROCK</u>	<u>89</u>	<u>170</u>
	<u>HARD SHALE</u>	<u>19</u>	<u>189</u>
	<u>COURSE SAND</u>	<u>17</u>	<u>206</u>
	<u>HARD SHALE</u>	<u>9</u>	<u>215</u>


Information upon completion of well:

- (1) Diameter 4x2 1/2 inches.
- (2) Total Depth 215 feet.  $\frac{215}{-10} = 205$
- (3) Water Level 10 feet below top of ground. ~~20~~
- (4) Cased to 215, Size  $\frac{175}{-30} = 145$  " 4" 30 " 2"
- (5) Screen: Size 2, Length 10
- (6) Were any formations sealed against pollution?  
yes,  no.

If YES depth of formation \_\_\_\_\_

Why \_\_\_\_\_

Drillers Remarks: \_\_\_\_\_

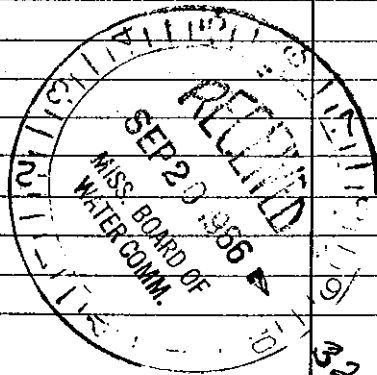

(Use Back Side)

Well No. 32