

HINDS
T 14

9-28-68

Miss Geo. Survey

9-28

date well completed

1968

MISSISSIPPI
BOARD OF WATER COMMISSIONERS
416 North State Street
Jackson, Mississippi 39201

4 holes
all logged by
MSG5

CODED

WATER WELL DRILLERS LOG

Leone-Central Company

Hinds

county well located

LANDOWNER: Southcentral

Water Association

(mailing address)

WELL LOCATION:

sec. 1 T 3 N R 3 E

Old Pine Grove Road

(distance) miles (direction) of (nearest town)

WELL PURPOSE: Domestic
(home, irrigation, municipal, industrial)

WELL COMPLETION DATA:

(1) diameter (inches) 16"

(2) total depth (feet) 536'

(3) static water level (feet) 130' below top of ground.

(4) casing 16" (size) if telescope see back.

(5) screen 50' (length) 480' (depth to top)

8" (size) Stainless Steel (material)

(6) pump (HP) (yield gpm)

Electric (type power)


(7) electric log Yes (yes or no)

Miss. Geo. Survey (organization running log)

(8) how well bottom plugged Valve

description of formations encountered	from	to
Red Sandey Clay	0	20
Hard Clay, Limestone	20	94
Sandy Clay	94	158
Hard Clay	158	229
Sand	229	250
Shale	250	253
Sand	253	297
Limestone, Shale, & soft lime	297	386
Clay	386	396
Sand & fine	396	408
Clay	408	475
Sand, Sand, & Pebbles of Clay	475	532
Clay	532	651

CODED

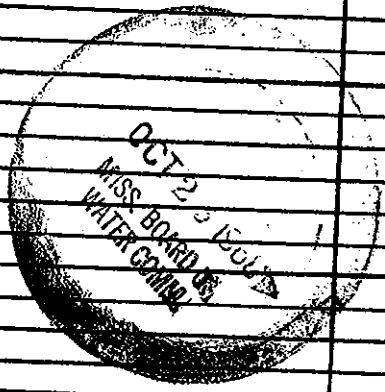

DRILLERS REMARKS:

Pump not installed as of this date