

CODED


HINDS
T 15
10-7-65

WATER WELL DRILLERS LOG

Date: 10/7, 1965, Driller: Forest Drilling Co. County Hinds
(Name)

(1) Owner of Land: <u>S.T. Kern</u> (Name)	Description & Color of Materials Sand, Clay, Red Clay, Shell, etc.	Thick- ness Feet	Depth Feet
<u>Rt 3 Box 166 Utica, Miss</u> (Address)	<u>Clay</u>		<u>12</u>
(2) Location: <u>8 TB 3N</u> 1/4, 1/4, Sec. <u>T R</u>	<u>Rock + clay</u>		<u>41</u>
on <u>Raymond</u> miles <u>North</u> of <u>Utica</u> (distance) (direction) (Nearest Town)	<u>Shale, blue (hard)</u>		<u>82</u>
(3) Topography: <u>4 M (Hilly)</u> (Elev)	<u>Shale</u>		<u>123</u>
(4) Purpose of Well: <u>Home</u> (Domestic Irrigation, Municipal, Industrial, Other)	<u>Shale + Shale</u>		<u>164</u>
Information upon completion of well:	<u>Shale</u>		<u>174</u>
(1) Diameter: <u>2x4"</u> inches.	<u>Sand</u>		<u>177</u>
(2) Total Depth: <u>385</u> feet.	<u>Blue shale</u>		<u>206</u>
(3) Water Level: <u>76</u> feet below top of ground.	<u>Rock + Sep. Shale</u>		<u>310</u>
(4) Cased to <u>176' - 4"</u> Size <u>2"</u>	<u>Rock + Sep. lime</u>		<u>328</u>
(5) Screen: Size <u>#7(2)</u> Length <u>5 ft</u>	<u>Rock + Sep. Shale</u>		<u>348</u>
(6) Were any formations sealed against pollution? <u>no</u>	<u>Shale</u>		<u>368</u>
If YES depth of formation _____	<u>Fine Sand</u>		<u>373</u>
Why _____			<u>385</u>
Drillers Remarks: _____			

CODED

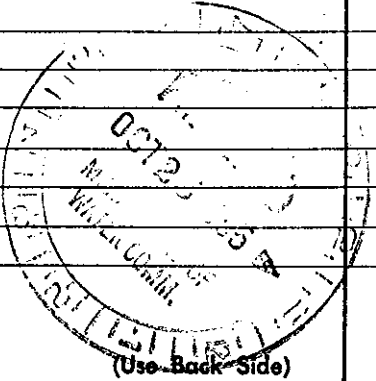

Well No.