

HINDS MISSISSIPPI BOARD OF WATER COMMISSIONERS

T 2000
1-13-66

WATER WELL DRILLERS LOG

Date: Jan 13 19 66, Driller: W. H. Butler County Hinds
(Name)

(1) Owner of Land: <u>Billy McPhearson</u> (Name)	Description & Color of Materials Sand, Clay, Red Clay, Shell, etc.	Thick- ness Feet	Depth Feet
<u>Utica Miss.</u> (Address)	<u>Clay</u>	<u>1-</u>	<u>10</u>
(2) Location: <u>1/4, 1/4, Sec. 4 T14R3N</u> <u>03W</u>	<u>Rock & chalk</u>	<u>10-</u>	<u>70</u>
<u>12</u> miles <u>S</u> , of <u>Raymond</u> (distance) (direction) (Nearest Town)	<u>chalk</u>	<u>70-</u>	<u>35</u>
(3) Topography: <input checked="" type="checkbox"/> (Hilly) <input type="checkbox"/> (Flat) <input type="checkbox"/> (Level)	<u>Sands</u>	<u>135</u>	<u>145</u>
(4) Purpose of Well: <u>Domestic Home</u> (Domestic Irrigation Municipal, Industrial, Other)			

Information upon completion of well:

(1) Diameter 2 inches.

(2) Total Depth 145 feet. ^{Hole} $\frac{145}{-10} = 135$

(3) Water Level 145 feet below top of ground. 145 well

(4) Cased to 135, Size 2"


(5) Screen: Size 2" Length 10'

(6) Were any formations sealed against pollution?
_____ yes, _____ no.

If YES depth of formation _____

Why _____

Drillers Remarks: _____

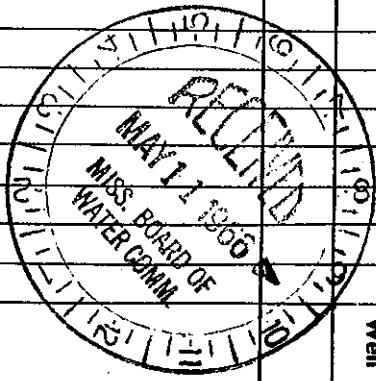

Well No.

(Use Back Side)

Mail this copy to Board of Water Commissioners 429 Miss. St. Jackson, Miss.