

HINDS MISSISSIPPI BOARD OF WATER COMMISSIONERS

T 2001
2-8-66

WATER WELL DRILLERS LOG


Date: Feb. 8, 1966, Driller: W. H. Butler County Hinds
(Name)

(1) Owner of Land: <u>S. O. McPherson</u> (Name)	Description & Color of Materials Sand, Clay, Red Clay, Shell, etc.	Thick- ness Feet	Depth Feet
<u>Raymond</u> (Address)	<u>Rock</u>	<u>1</u>	<u>10</u>
(2) Location: <u>3/4</u> , <u>3/4</u> , Sec. <u>4</u> T <u>4</u> R <u>3</u> E <u>W</u>	<u>Rock + chalk</u>	<u>10</u>	<u>20</u>
<u>12</u> miles <u>S.</u> of <u>Raymond</u> (distance) (direction) (Nearest Town)	<u>Rock</u>	<u>20</u>	<u>80</u>
(3) Topography: <input checked="" type="checkbox"/> (Hilly) <input type="checkbox"/> (Flat) <input type="checkbox"/> (Level)	<u>Rock + little sand</u>	<u>80</u>	<u>100</u>
(4) Purpose of Well: <u>Domestic Home</u> (Domestic Irrigation, Municipal, Industrial, Other)	<u>Chalk + Rock</u>	<u>100</u>	<u>110</u>
	<u>Rock</u>	<u>110</u>	<u>130</u>
	<u>Chalk</u>	<u>130</u>	<u>160</u>
	<u>Chalk + Sand</u>	<u>160</u>	<u>170</u>
	<u>Chalk</u>	<u>170</u>	<u>200</u>
	<u>Rock + Chalk</u>	<u>200</u>	<u>212</u>
	<u>Rock</u>	<u>212</u>	<u>258</u>
	<u>Sand + Chalk</u>	<u>258</u>	<u>271</u>

Information upon completion of well:

- (1) Diameter 2" inches.
- (2) Total Depth 271 feet.
- (3) Water Level _____ feet below top of ground.
- (4) Cased to 160, Size 2"
- (5) Screen: Size open hole, Length _____
- (6) Were any formations sealed against pollution?
_____ yes, _____ no.

If YES depth of formation _____
Why _____
Drillers Remarks: _____

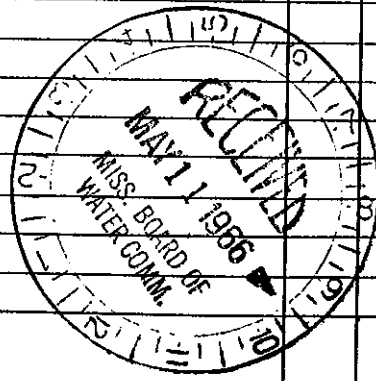

Well No. _____

(Use Back Side)

Mail this copy to Board of Water Commissioners 429 Miss. St. Jackson, Miss.