

HINDS  
U21


MISSISSIPPI BOARD OF WATER COMMISSIONERS

WATER WELL DRILLERS LOG

9-3-65

Date: Sept. 3, 1965, Driller: Burney Well Service, Inc County Hinds  
E Log 227 (Name)

(1) Owner of Land: <u>P. L. Ainsworth</u> (Name)	Description & Color of Materials Sand, Clay, Red Clay, Shell, etc.	Thick- ness Feet	Depth Feet
<u>Terry, Miss.</u> (Address)	Top soil	10	10
<u>West end of Green Gables Road</u> (2) Location: <u>1/4, 1/4, Sec. T R</u>	Rock	20	30
<u>3 1/2</u> miles <u>West</u> of <u>Terry</u> (distance) (direction) (Nearest Town)	Blue Clay	10	40
(3) Topography: <u>Hilly</u> (Hilly) (Flat) (Level)	Sand	10	50
(4) Purpose of Well: <u>Domestic</u> (Domestic Irrigation Municipal, Industrial, Other)	Rock	20	70
Information upon completion of well:	Sand	22	92
(1) Diameter <u>4 x 2</u> inches.	Clay	5	97
(2) Total Depth <u>612</u> feet.	Rock	6	103
(3) Water Level <u>133</u> feet below top of ground.	Clay & Sand layers	20	123
(4) Cased to <u>310'</u> , Size <u>4"</u> <u>183'</u> <u>2"</u>	Rock formations	32	155
(5) Screen: Size <u>2 1/2"</u> , Length <u>20'</u>	Blue clay & Rock layers	47	202
(6) Were any formations sealed against pollution? <u>X</u> yes, <u>      </u> no.	Sand layers & Blue clay	78	280
If YES depth of formation <u>from surface</u>	Sand & Shale layers	29	300
Why <u>to prevent surface pollution</u>	Sand layer	10	310
Drillers Remarks: <u>well seal used</u>	Fine sand	20	330
	Sand layers	57	387
	Hard rock	45	432
	Shale & Sand layers	31	463
	Fine sand & Soft form	40	503
	Sand layers	47	550
	Tight clay	25	575
	Fine sand	32	612

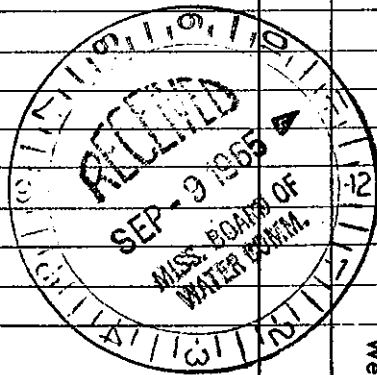

Well No.

(Use Back Side)

Mail this copy to Board of Water Commissioners 429 Miss. St. Jackson, Miss: