

HINDS MISSISSIPPI BOARD OF WATER COMMISSIONERS

U 2000
11-14-60

WATER WELL DRILLERS LOG

Date: Nov 14, 19 60, Driller: Burney Water Well Serv County Hinds
(Ben Burney & Son)

(1) Owner of Land:	Description & Color of Materials Sand, Clay, Red Clay, Shell, etc.	Thick- ness Feet	Depth Feet
James Hughes (Name)	Topsoil & Buckshot	14	14
Terry, Miss. (Address)	Blue/grey clay	40	54
Pinegrove Road (Address)	Rock	18	72
(2) Location: 1/4, 1/4, Sec. T. 31/24	Soft blue formation	13	85
5 miles west, of Terry (distance) (direction) (Nearest Town)	Layers sand	8	93
(3) Topography: Hilly (Hilly) (Flat) (Level)	Hard black formation	16	109
(4) Purpose of Well: Domestic Home (Domestic Irrigation Municipal, Industrial, Other)	Blue/grey clay	10	119
	Hard blue clay	14	133
	Layers sand	27	160


Information upon completion of well:

- (1) Diameter 4 inches.
- (2) Total Depth 160 feet. *160*
155
- (3) Water Level 48 feet below top of ground. *155*
- (4) Cased to 1585 feet, Size 2"
- (5) Screen: Size 2", Length 5'
- (6) Were any formations sealed against pollution?
X yes, no.

If YES depth of formation From surface

Why To prevent surface pollution

Drillers Remarks:

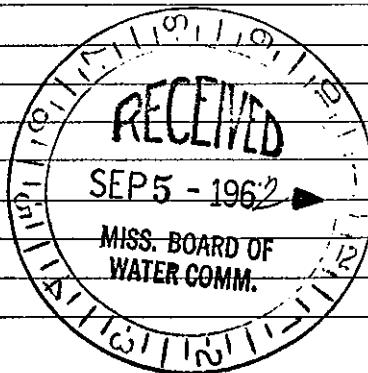

(Use Back Side)

Well No.

Mail this copy to Board of Water Commissioners 429 Miss. St. Jackson, Miss.