

HINDS

U 2001

4-19-61

MISSISSIPPI BOARD OF WATER COMMISSIONERS

WATER WELL DRILLERS LOG

Date: April 19, 1961, Driller: Burney Water Well Serv County Hinds (Ben Burney & Son)

(1) Owner of Land: Bryant Stubbs (Name)	Description & Color of Materials Sand, Clay, Red Clay, Shell, etc.	Thick- ness Feet	Depth Feet
Terry, Miss. (Address)	Topsoil & white clay	20	20
Green Gable Road 1/4, 1/4, Sec. T24R24	Blue clay	25	45
5 miles West of Terry (distance) (direction) (Nearest Town)	Fine Blue sand	7	52
(3) Topography: Hilly (Hilly) (Flat) (Level)	Blue shale & clay	11	63
(4) Purpose of Well: Domestic Home (Domestic Irrigation Municipal, Industrial, Other)			


Information upon completion of well:

- (1) Diameter 4 inches.
- (2) Total Depth 63 feet. $\frac{63}{53}$
- (3) Water Level 18 feet below top of ground.
- (4) Cased to 52' 53", Size 2"
- (5) Screen: Size 1/2" 2", Length 10'
- (6) Were any formations sealed against pollution?
 yes, no.

If YES depth of formation From surface

Why To prevent surface pollution

Drillers Remarks:

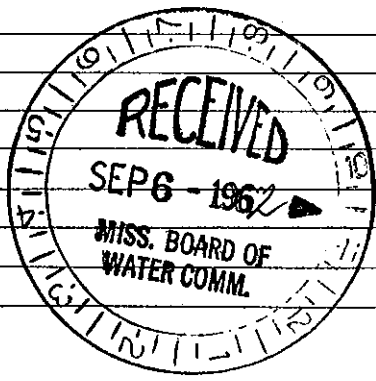

(Use Back Side)

Well No.