

U 2004


7-27-63

WATER WELL DRILLERS LOG

Date: July 27, 1963, Driller: Ben Burney County Hinds

(Name)

	Description & Color of Materials Sand, Clay, Red Clay, Shell, etc.	Thick- ness Feet	Depth Feet
(1) Owner of Land: <u>Mr. Tom Williams</u> (Name)	Top Soil & Clay	8	8
Rt. 1, Terry, Mississippi (Address)	Red Sand	13	21
Dry Grove Road (2) Location: $\frac{1}{4}$, $\frac{1}{4}$, Sec. <u>T/R 24</u>	Pipe & Gray Clay	14	35
<u>1 1/2</u> miles <u>West</u> of <u>Wyndale Store</u> (distance) (direction) (Nearest Town)	Blue Clay	30	65
(3) Topography: <u>Hilly</u> (Hilly) (Flat) (Level)	Soft Sand Formation	10	75
(4) Purpose of Well: <u>Domestic Home</u> (Domestic Irrigation Municipal, Industrial, Other)	Soft Blue Formation	10	85
Information upon completion of well:	Soft Sandy Formation	5	90
(1) Diameter <u>4</u> inches.	Blue & Gray Clay	53	143
(2) Total Depth <u>202</u> feet.	Rock Layers	7	150
(3) Water Level <u>78</u> feet below top of ground.	Fine Tight Sand Layers	11	161
(4) Cased to <u>176'</u> , Size <u>2"</u>	Fine Sand	4	165
(5) Screen: Size <u>2 1/2"</u> , Length <u>5'</u>	Clay	5	170
(6) Were any formations sealed against pollution? <u>X</u> yes, _____ no.	All Sand	4	174
If YES depth of formation <u>from surface</u>	Clay	2	176
Why to prevent surface pollution	Layers of Clay & Sand	6	182
Drillers Remarks:	All Clay	20	202

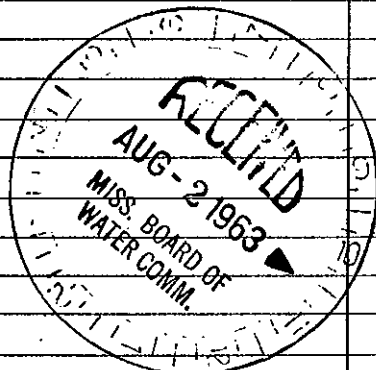

(Use Back Side)

Well No.