

HINDS

MISSISSIPPI BOARD OF WATER COMMISSIONERS


✓ 300

✓
9-29-60

WATER WELL DRILLERS LOG

Date: 9/29, 1960, Driller: Johnnie Beasley County Hinds
(Name)

	Description & Color of Materials Sand, Clay, Red Clay, Shell, etc.	Thick- ness Feet	Depth Feet
(1) Owner of Land: <u>Jessie H. McQueary</u> (Name)	Silt.	0	5
<u>Terry, Miss.</u> (Address)	Chalk.	5	25
(2) Location: <u>1/4</u> , <u>1/4</u> , Sec. <u>T34R</u>	Hard blue clay.	25	70
<u>1</u> miles <u>south</u> , of <u>Terry</u> (distance) (direction) (Nearest Town)	Blue clay & Stks. silt	70	80
(3) Topography: <u>X</u> (Hilly) (Flat) (Level)	Hard blue clay.	80	166
(4) Purpose of Well: <u>Domestic.</u> (Domestic Irrigation Municipal, Industrial, Other)	Silt & stks. shale.	166	175
Information upon completion of well:	Blue clay.	175	185
(1) Diameter <u>2</u> inches.	Sand. (Screen set.)	185	195
(2) Total Depth <u>195</u> feet.	Blue clay.	195	205
(3) Water Level <u>35</u> feet below top of ground.	Gumbo.	205	225
(4) Cased to <u>185'</u> , Size <u>2"</u>			
(5) Screen: Size <u>2"</u> , Length <u>10'</u>			
(6) Were any formations sealed against pollution? <u>yes</u> , <u>X</u> no.			
If YES depth of formation _____			
Why _____			
Drillers Remarks: <u>Good well.</u>			

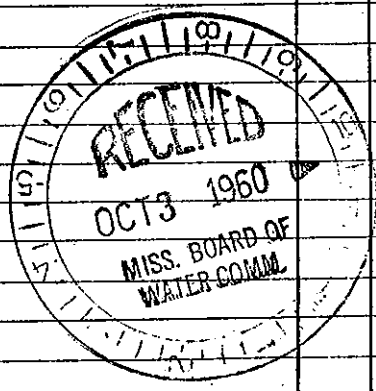

Well No.

(Use Back Side)

Mail this copy to Board of Water Commissioners 429 Miss. St. Jackson, M