

V 058
G.W.

Hinds
V0007
8-68
6565

MISSISSIPPI
BOARD OF WATER COMMISSIONERS
416 North State Street
Jackson, Mississippi 39201

CODED

WATER WELL DRILLERS LOG


8-3 1968 Hines Water Well Serv. Hinds
date well completed firm name county well located

LANDOWNER:	description of formations encountered	from	to
Last Side Water serv Terry, Miss. (mailing address)			
WELL LOCATION: sec. 10 T. 3 N. R. 1 E S W	white sand & gravel	10	50
	Blue chalk	50	422
	fine sand	422	485
	U. sand	485	525
(distance) miles (direction) of (nearest town)			

WELL PURPOSE: Community
(home, irrigation, municipal, industrial)

WELL COMPLETION DATA:

- (1) diameter (inches) 12"
- (2) total depth (feet) 525'
- (3) static water level (feet) 136' below above top of ground.
- (4) casing black pipe 485'
(material) (depth)
8" If telescope see back.
(size)
- (5) screen 30' 495'
(length) (depth to top)
6" 5.5.
(size) (material)
- (6) pump 20 175
(HP) (yield gpm)
electric
(type power)
- (7) electric log yes
(yes or no)
U.S. Geological
(organization running log)
- (8) how well bottom plugged _____

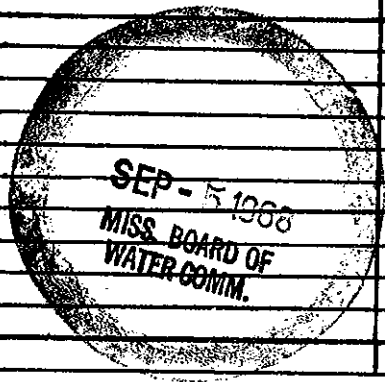

DRILLERS REMARKS: