

RANKIN MISSISSIPPI BOARD OF WATER COMMISSIONERS


V 18
9-11-64

WATER WELL DRILLERS LOG

Date: 9-11-, 1964, Driller: JAMES McNEES County HINDS

(Name)

(1) Owner of Land	Description & Color of Materials Sand, Clay, Red Clay, Shell, etc.	Thick- ness Feet	Depth Feet
<u>FRENK STEVENS</u> (Name) <u>5224 MISS</u> (Address)	SURFACE SOIL	3	3
(2) Location: $\frac{1}{4}$, $\frac{1}{4}$, Sec. <u>31 T31R8</u>	SAND ROCK	17	20
<u>4</u> miles <u>SE</u> , of <u>STEV</u> (distance) (direction) (Nearest Town)	CLAY	15	35
(3) Topography: _____ (Hilly) (Flat) (Level)	SAND	5	40
(4) Purpose of Well: _____ (Domestic Irrigation, Municipal, Industrial, Other)	BLUE SHALE	53	93
Information upon completion of well:	SAND	22	115
(1) Diameter <u>2</u> inches.	BLUE SHALE	45	160
(2) Total Depth <u>275</u> feet.	GREY SDY SH SD STKS	30	190
(3) Water Level <u>157</u> feet below top of ground.	ROCK SH STKS	15	205
(4) Cased to <u>251 6</u> , Size _____	GREY SH	31	236
(5) Screen: Size <u>1 1/4</u> , Length <u>10'</u>	SAND	3	239
(6) Were any formations sealed against pollution?	GREY SH	11	250
_____ yes, <input checked="" type="checkbox"/> no.	SAND	25	275
If YES depth of formation _____			
Why _____			
Drillers Remarks: _____			

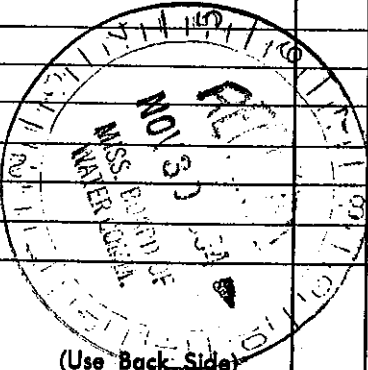

Well No.

(Use Back Side)

Mail this copy to Board of Water Commissioners 429 Miss. St. Jackson, Miss.