

HINDS
V49
2-25-65


MISSISSIPPI BOARD OF WATER COMMISSIONERS

Electric Miss Geological Survey
WATER WELL DRILLERS LOG

Date: 2-25, 1965, Driller: JAMES McNEES County HINDS

(Name)

		Description & Color of Materials Sand, Clay, Red Clay, Shell, etc.	Thick- ness Feet	Depth Feet
(1) Owner of Land: <u>J. E. Lawrence</u> (Name) <u>Terry Mills</u> (Address)		<u>Surface soil</u>	<u>23</u>	<u>23</u>
(2) Location: $\frac{1}{4}$, $\frac{1}{4}$, Sec <u>20 T3N R1</u> <u>4</u> miles <u>SW</u> , of <u>Terry</u> (distance) (direction) (Nearest Town)		<u>Clay</u>	<u>27</u>	<u>50</u>
(3) Topography: <u>—</u> (Hilly) (Flat) (Level)		<u>Grey sh sd strk</u>	<u>28</u>	<u>78</u>
(4) Purpose of Well: <u>DOMESTIC HOM</u> (Domestic Irrigation Municipal, Industrial, Other)		<u>Grey shale</u>	<u>8</u>	<u>160</u>
Information upon completion of well:		<u>SEND</u>	<u>6</u>	<u>166</u>
(1) Diameter: <u>4 X 2</u> inches.		<u>Grey shale</u>	<u>9</u>	<u>175</u>
(2) Total Depth: <u>675</u> feet.		<u>Rock</u>	<u>2</u>	<u>177</u>
(3) Water Level: <u>143</u> feet below top of ground.		<u>Grey shale</u>	<u>209</u>	<u>386</u>
(4) Cased to: <u>614</u> , Size: _____		<u>SEND</u>	<u>5</u>	<u>391</u>
(5) Screen: Size: <u>2" 008</u> , Length: <u>20</u>		<u>Grey shale</u>	<u>78</u>	<u>469</u>
(6) Were any formations sealed against pollution? _____ yes, <input checked="" type="checkbox"/> no.		<u>Light sh strk</u>	<u>27</u>	<u>496</u>
If YES depth of formation: _____		<u>SEND sh strk</u>	<u>16</u>	<u>512</u>
Why: _____		<u>Grey sdy sh</u>	<u>73</u>	<u>585</u>
Drillers Remarks: _____		<u>SEND</u>	<u>90</u>	<u>675</u>
		<u>14 JTS 4"</u>	<u>295</u>	
		<u>1-4" X 2" SWAGE</u>	<u>1</u>	
			<u>296</u>	
		<u>16 JTS 2"</u>	<u>318</u>	
			<u>614</u>	
		<u>2-10' 009 SSS</u>	<u>20</u>	
			<u>634</u>	
		<u>1-JT 2" BPV</u>	<u>12</u>	
			<u>646</u>	

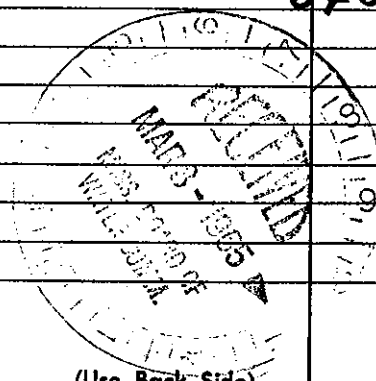

(Use Back Side)

Well No.

Mail this copy to Board of Water Commissioners 429 Miss. St. Jackson, Miss