

HINDS

V52

11-8-65

MISSISSIPPI BOARD OF WATER COMMISSIONERS
Electrical and Miss Geological Survey

WATER WELL DRILLERS LOG

Date: 11-8-65, Driller: James McNEES County Hinds
E Log 235 (Name)

(1) Owner of Land: R.C. SANFORD
(Name)

Terry MISS
(Address)

(2) Location: NW 1/4, SW 1/4, Sec. 5 T3 R14

4 miles West of Terry
(distance) (direction) (Nearest Town)

(3) Topography: (Hilly) (Flat) (Level)

(4) Purpose of Well: Domestic
(Domestic Irrigation, Municipal, Industrial, Other)

Information upon completion of well:

(1) Diameter: 4" x 2" inches.

(2) Total Depth: 458 feet.

(3) Water Level: 120 feet below top of ground.

(4) Cased to 305, Size 4"

(5) Screen: Size 2" 007, Length 5

(6) Were any formations sealed against pollution?


yes, no.

If YES depth of formation

Why

Drillers Remarks: White Water

Description & Color of Materials Sand, Clay, Red Clay, Shell, etc.	Thick- ness Feet	Depth Feet
Surface soil	15	15
ROCK	1	16
SAND	64	80
SANDY SH	7	87
ROCK	3	90
Blue shale	35	125
SAND	5	130
ROCK sh strks	30	160
Grey shale	35	195
SAND	8	203
Grey shale	70	273
lime	46	319
SANDY SH	14	333
SAND sh strks	46	379
Grey sh	3	382
Grey sdy sh	36	418
Grey shale	40	458
15 Jts 4"	305	
1-4" x 3" swedge	1	
	306	
1-Jt 2" with 4"	18	
X 2" Lead seal		
	324	
2-2" Johnson screens	8	
	332	

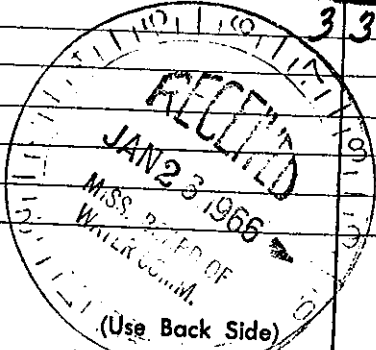

Well No.

Mail this copy to Board of Water Commissioners 429 Miss. St. Jackson, Miss.