

E-109 # 275

WELL

Hinds
V-56
7-67
Elec Log

MISSISSIPPI
BOARD OF WATER COMMISSIONERS
416 North State Street
Jackson, Mississippi 39201

E-109 # 275

WATER WELL DRILLERS LOG

July 14, 1967 Burrey Water Well Service, Inc. Hinds
date well completed firm name county well located

LANDOWNER: T. P. Hobbs

Route 1, Box 4-B

Terry, Miss.

(mailing address)

WELL LOCATION:

sec 9 T 3 N R 1 E

1 miles North of Terry
(distance) (direction) (nearest town)

WELL PURPOSE: home
(home, irrigation, municipal, industrial)

WELL COMPLETION DATA:

- (1) diameter (inches) 4"
- (2) total depth (feet) 130
- (3) static water level (feet) 32 below top of ground.

(4) casing Galv., 12 1/4"
(material) (depth)

(size) if telescope see back.

(5) screen 6' 12 1/4"
(length) (depth to top)

2" Johnson S.S.
(size) (material)

(6) pump 1 900 GPH
(HP) (yield gpm)

Electric
(type power)

(7) electric log yes
(yes or no)


Miss. Geological Survey
(organization running log)

(8) how well bottom plugged Bark Wash Valve

description of formations encountered

from to

Buckshot top soil	0	5
Grey clay	5	22
Limestone	22	26
Black Marl or clay	26	31
Hard blue clay	31	55
Soft Blue clay	55	68
Fine sand layers	68	86
Blue clay	86	90
Grey & Black clay	90	108
Blue Clay	108	116
Fine sand layers	116	120
All fine sand	120	128
Tight @mho	128	142
Black Marl	142	162

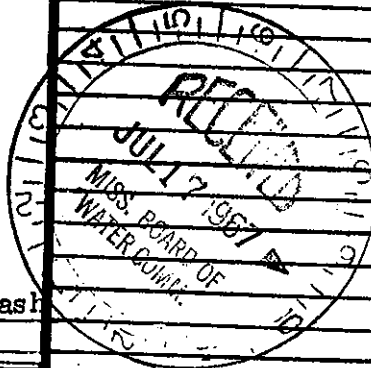

DRILLERS REMARKS: