
	State V	Vell Report		
County: 141NUS	]	Part 1	For Office Use Only:	
Permit #:	Mississippi Department of Environmental Quality Office of Land and Water Resources		Aquifer:	
Driller: Water well Service		Box 10631	Well #: <u>V-126</u>	
Date drilling completed: 9-18-06		AS 39289-0631	L. S. Elevation:	
		961-5210 4-6938 (fax)	E-log #:	
State Law requires that this repo 30 days of completion of drilling	rt be prepared by the			
Well Owner Informat	ion	Well	Location	
Owner Name Scott Coulo		Latitude: 32.06, 45	" Longitude: 90 . 19.42	
Mailing Address: 115 Pine	Hill Lane	Method of Lat/Long (circle on	e): Conventional Survey,	
-		USGS quad, Hand-held	GPS, Survey-grade GPS	
<u>Triry</u> Ms 39170 City State Zip Code		<u>NW 45W 4 Sec 8 Twn 318 Rng IW</u>		
Telephone No. (60) 939-0	441	Distance Direction Nearest Town Miles of		
	Well I	Jata		
Purpose of Well (circle one Home Indus	trial Public Supply	Irrigation Fish Culture	Other:	
Date well drilling started: 9-14-		vell drilling completed: <u>2-1</u>	8-04	
If flowing, method of flow regulation: Valve				
Static Water Level:feet abov	e or below (circle one) la	and surface Date measured:	9-21-04	
Method of Measurement (circle one) stee	tape electric tape	air line other:		
Hole depth: 360 Well depth	178	Well grouted to a depth of	<u>25</u> _feet	
Type of grout (circle one): Cement			0	
Casing length: <u>148</u> feet Casing	diameter:	_inches Type of casing:	puc	
Screen length: <u>20</u> feet Screen	diameter: <u>4</u>	_inches Type of screen:	PUC	
Screen slot size: <u>0.08</u> inches	Setting depth: From	148 feet to	feet	
Type of completion (circle all applicable):	Travel packed Underre	eamed Telescoped Open h	ole Natural Development	
	Other (describe):			
Top of lap pipe or reduction in casing:	feet. If tele	scoped or more than one scree	n, describe on back of page	
Logs run (circle all applicable): No log run		Density Sonic Neutron O	ther:	
Name of organization running log(s):				
I certify that the well was drilled, construct Department of Environmental Quality and/				
Arnold Fincher Sr	059X		Senet Se	
Print Name of Water Well Contractor and Lice	ense No.	Signature of W	/ater Well Contractor	
	1		RECEIVED	

0CT 1 8 2006 BY: OLW R if well telescopes please sketch bele

Ground Level

	Description of Formations Encounts	V-126	To
	Clay		-13
	Sert	180	y.
	Pacifi	273	3
	Sand	33	13
	Clu1	343	2
	/		÷
			+
			1
			1
			T
			4
			-
			_
			-+
			******
•			
			<del></del>

If more than one screen, show location of each on sketch

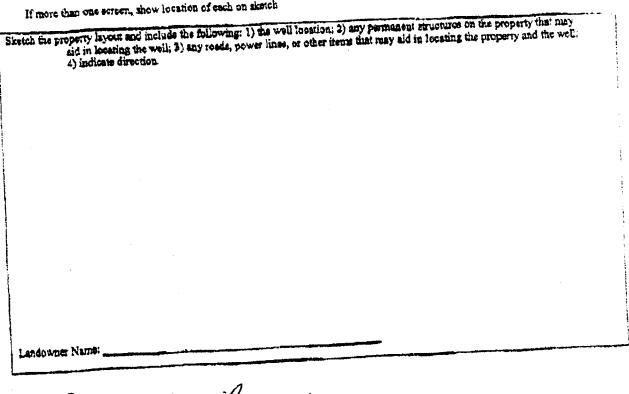

Junch 5/ Well Contractor

Signature of Water

RECEIVED OCT 18 2006 BY: OLWR

		STATE V	VELL REPORT	
County: Permit #: Driller: Date completed: ? This report sh	r weel Sero -26-66		Part 2	
installation of	pump. Well Owner Info			
Owner Name: 5	Owner Name: <u>Scott Coulon</u> Mailing Address: 115 Pine Hill Lane		Well Location Latitude: <u>32-06-45</u> Longitude: <u>90-19-4</u> Method of Lat/Long (circle one): Conventional Survey,	
Telephone No.	-	<u>Ms 39170</u> ate Zip Code 5-0461	USGS quad, H	and-held GPS, Survey-grade GF
	Pump Typ Circle one			Power Type Circle one
Air Lift	Jet	Submersible	Diesel Engine Gase	oline Engine Natural (
Bucket	Piston	Turbine	Electric Motor Han	· · ·
Centrifugal	Rotary	Flowing Well		er (specify):
Other (specify): Date Pump Installed Rated Pump Capacit	-	Gallons Per Minute	Horse Power Rating of Mor Setting Depth:	tor: 1. D
Date Well Tested:	Pump Test Data Date Well Tested: 9-24-04		Method of Measuring Water Level Circle one	
Static Water Level (A Pumping Water Leve	A): <u>64</u> H (B): <u>80</u> H	Feet Below Land Surface Seet Below Land Surface		leasuring Line Steel Tape
Drawdown [(B) - (A)]:Feet Below Land Surface Test Pumping Rate:Gallons Per Minute			shut in head:fe	
Duration of Pump Te	st (minimum 4 hou	urs): <u> </u>		hours of pumpi
Ctor HING	18 Finde	atements are true to the best - 5- 0598 se No. (if applicable)	of my knowledge.	Junch S-

BY: OLWP