

HINDS

V 2006

7-62

MISSISSIPPI BOARD OF WATER COMMISSIONERS

WATER WELL DRILLERS LOG

Date: JULY, 1962, Driller: McNEECE DRILLING Co. County HINDS

(Name)

(1) Owner of Land: <u>CECIL YARBROUGH</u> (Name)	Description & Color of Materials Sand, Clay, Red Clay, Shell, etc.	Thick- ness Feet	Depth Feet
<u>R.I. TERRY MISS</u> (Address)	SURFACE SOIL	12	12
(2) Location: <u>1/4, NW 1/4, Sec. 20 T3N R1W</u>	WHITE SAND & SAND ROCK	28	40
<u>2</u> miles <u>W</u> of <u>TERRY</u> (distance) (direction) (Nearest Town)	GREY SHALE	68	108
(3) Topography: <u>FLAT</u> (Hilly) (Flat) (Level)	FINE SAND & SHALE	22	130
(4) Purpose of Well: <u>DOMESTIC HOME</u> (Domestic Irrigation Municipal, Industrial, Other)	GREY SHALE	120	250
	SHALE & SAND	49	299
	ROCK LEDGES	53	352
	FINE SAND	14	364
	SHALE & SAND	37	401
	FINE SAND	17	418
	SHALE & LIGNITE	45	463
	COARSE SAND	27	490

Information upon completion of well:

- (1) Diameter 4 X 2 inches.
- (2) Total Depth 490 feet. ⁴⁹⁰ ~~480~~
- (3) Water Level 83 feet below top of ground.
- (4) Cased to 250 480, Size 4"
250-490-2"
- (5) ~~Size~~ Size 2", Length 10


(6) Were any formations sealed against pollution?

yes, X no.

If YES depth of formation _____

Why _____

Drillers Remarks: _____

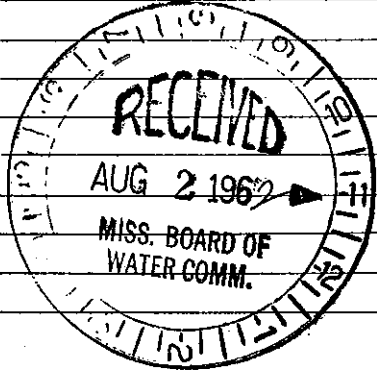

(Use Back Side)

Well No. 37

Mail this copy to Board of Water Commissioners 429 Miss. St. Jackson, Miss