

HINDS

MISSISSIPPI BOARD OF WATER COMMISSIONERS

V 2011  
5-16-63

WATER WELL DRILLERS LOG

Date: 5/16, 1963, Driller: Frank Dalg Sevier County, Sevier Tenn

(Name)

(1) Owner of Land: <u>Wesley Wilson</u> (Name)	Description & Color of Materials Sand, Clay, Red Clay, Shell, etc.	Thick- ness Feet	Depth Feet
<u>Jerry, Oriskany</u> (Address)	<u>Clay</u>	<u>0</u>	<u>18</u>
(2) Location: <u>1/4</u> , <u>1/4</u> , Sec. <u>34/1N</u>	<u>Sand &amp; Rock</u>		<u>21</u>
<u>2</u> miles <u>West</u> , of <u>Jerry</u>	<u>Hard Shale</u>		<u>80</u>
(distance) (direction) (Nearest Town)	<u>Packed Sand</u>		<u>94</u>
(3) Topography: <u>X</u>	<u>Sand + Shls Clay</u>		<u>100</u>
(Hilly) (Flat) (Level)			
(4) Purpose of Well: <u>Home</u> (Domestic Irrigation Municipal, Industrial, Other)			


Information upon completion of well:

- (1) Diameter 2" inches.
- (2) Total Depth 100 <sup>100</sup> <sub>15</sub> <sup>8</sup> <sub>5</sub> feet.
- (3) Water Level 60 feet below top of ground. <sub>100 well</sub>
- (4) Cased to 85, Size 2"
- (5) Screen: Size 2" , Length 15 ft.
- (6) Were any formations sealed against pollution?  
yes, X no.

If YES depth of formation \_\_\_\_\_

Why \_\_\_\_\_

Drillers Remarks: \_\_\_\_\_

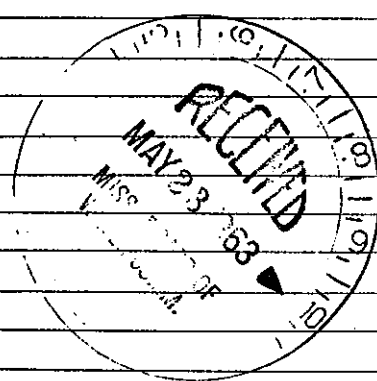

Well No.

(Use Back Side)

~~Attach this copy for your office files.~~