

HINDS MISSISSIPPI BOARD OF WATER COMMISSIONERS


V 7018

8-10-64

WATER WELL DRILLERS LOG

Date: 8/10, 1964, Driller: M. Gray County Hardie
 (Name)

(1) Owner of Land: <u>TERRY PLESANT</u> (Name)	Description & Color of Materials Sand, Clay, Red Clay, Shell, etc.	Thick- ness Feet	Depth Feet
<u>Terry</u> (Address)	<u>White Sandy Rock</u>	<u>0</u>	<u>20</u>
(2) Location: <u>30/1/14</u>	<u>Rock - Sand</u>	<u>20</u>	<u>40</u>
<u>5</u> miles <u>SE</u> of <u>Terry</u> (distance) (direction) (Nearest Town)	<u>Rock - Sand</u>	<u>40</u>	<u>60</u>
(3) Topography: <input checked="" type="checkbox"/> (Hilly) <input type="checkbox"/> (Flat) <input type="checkbox"/> (Level)	<u>Rock - Clay</u>	<u>60</u>	<u>80</u>
(4) Purpose of Well: <u>Home</u> (Domestic Irrigation, Municipal, Industrial, Other)	<u>Clay - Sandy Rock</u>	<u>80</u>	<u>100</u>
Information upon completion of well:	<u>Blue clay</u>	<u>100</u>	<u>120</u>
(1) Diameter <u>4 1/2</u> inches.	<u>Sandy Clay - Rock</u>	<u>300</u>	<u>340</u>
(2) Total Depth <u>565</u> ^{1 hole} feet. <u>565</u> ₃₀ <u>545</u>	<u>Clay - Sandstone</u>	<u>360</u>	<u>420</u>
(3) Water Level <u>184</u> feet below top of ground. <u>300</u> well	<u>Shell - Clay</u>	<u>460</u>	<u>480</u>
(4) Cased to <u>350</u> , Size <u>4"</u>	<u>Rock - Clay</u>	<u>480</u>	<u>500</u>
(5) Screen: Size <u>007</u> , Length <u>20</u>	<u>Sand</u>	<u>500</u>	<u>520</u>
(6) Were any formations sealed against pollution? <u>no.</u>	<u>Med Sand.</u>	<u>520</u>	<u>565</u>
If YES depth of formation	<u>Sub Pump</u>		
Why			
Drillers Remarks:			

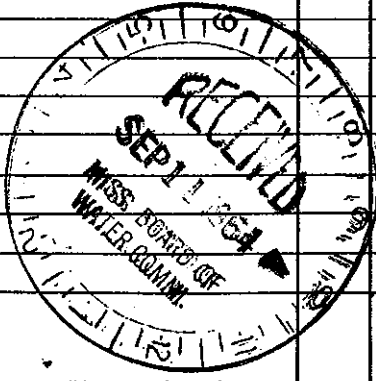

(Use Back Side)

Well No.

Mail this copy to Board of Water Commissioners 429 Miss. St. Jackson, Miss