

HINDS MISSISSIPPI BOARD OF WATER COMMISSIONERS

V 2019
6-3-65

WATER WELL DRILLERS LOG

Date: JUNE 3, 19 65, Driller: HALL DRILLING CO County HINDS

(Name)

(1) Owner of Land: F.M. RICE
(Name)

RT 2 TERRY MISS
(Address)

(2) Location: SW 1/4, 1/4, Sec. 17 W 3/4
3 1/2 miles W of TERRY
(distance) (direction) (Nearest Town)

(3) Topography: FLAT
(Hilly) (Flat) (Level)

(4) Purpose of Well: DOMESTIC HOME
(Domestic Irrigation
Municipal, Industrial, Other)

Description & Color of Materials Sand, Clay, Red Clay, Shell, etc.	Thick- ness Feet	Depth Feet
<u>SURFACE SOIL</u>	<u>3</u>	<u>3</u>
<u>YELLOW MARL</u>	<u>17</u>	<u>20</u>
<u>BLUE SHALE</u>	<u>21</u>	<u>41</u>
<u>ROCK + SAND</u>	<u>22</u>	<u>63</u>
<u>DARK BROWN SHALE + ROCK</u>	<u>18</u>	<u>248</u>
<u>SAND + LIGNITE</u>	<u>89</u>	<u>337</u>
<u>SHALE + ROCK</u>	<u>43</u>	<u>380</u>
<u>SAND + SEA SHELL</u>	<u>10</u>	<u>390</u>
<u>SHALE + LIGNITE</u>	<u>50</u>	<u>445</u>
<u>SAND + LIGNITE</u>	<u>21</u>	<u>466</u>
<u>SAND + SHALE</u>	<u>20</u>	<u>486</u>
<u>COURSE SAND</u>	<u>44</u>	<u>530</u>

Information upon completion of well:

(1) Diameter 4 1/2 inches.

(2) Total Depth 530 feet. 530
1012
516

(3) Water Level 138 feet below top of ground.

(4) Cased to 530 Size 250' - 4"
260' - 2"
Casing 5 10


(5) Screen: Size 2", Length 20'

(6) Were any formations sealed against pollution?
yes, X no.

If YES depth of formation _____

Why _____

Drillers Remarks: _____

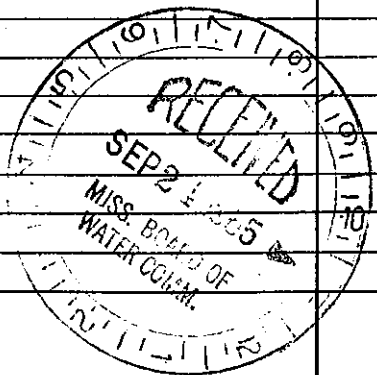

(Use Back Side)

Well No. _____

Mail this copy to Board of Water Commissioners 429 Miss. St. Jackson, Miss