

105 MISSISSIPPI BOARD OF WATER COMMISSIONERS

12870

10-11-65

WATER WELL DRILLERS LOG

Date: Oct 11, 1965, Driller: MCKAY County: HINDS
(Name)

(1) Owner of Land: <u>Herbert Beauford</u> (Name)	Description & Color of Materials Sand, Clay, Red Clay, Shell, etc.	Thick- ness Feet	Depth Feet
<u>Tenn</u> (Address)	White Clay	0	20
(2) Location: <u>1/4, 1/4, Sec 16 T32N R12W</u>	Blue clay	20	40
_____ miles _____ of _____ (distance) (direction) (Nearest Town)	Blue clay	40	100
(3) Topography: _____ (Hilly) (Flat) (Level)	Rock	100	101
(4) Purpose of Well: <input checked="" type="checkbox"/> Home (Domestic Irrigation Municipal, Industrial, Other)	Blue clay	101	180
	Fine Sand	180	200
	Clay - Shale	200	420
	Rock - Shale	420	460
	Blue clay	460	560
	Sand	560	615

Information upon completion of well:


- (1) Diameter 4 1/2 inches.
- (2) Total Depth 615 ^{Hole} feet.
- (3) Water Level 90 feet below top of ground.
- (4) Cased to 315 ^{25' well} Size 4
- (5) Screen: Size 20, Length 20
- (6) Were any formations sealed against pollution?
_____ yes, no.

If YES depth of formation _____

Why _____

Drillers Remarks: _____

1/2 HP 16 S. Sub
Pump

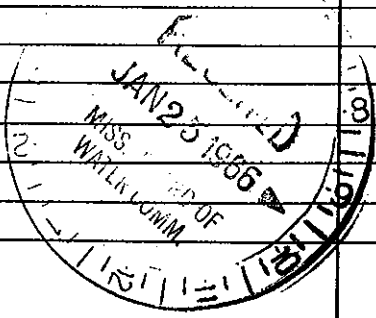

(Use Back Side)

Well No.

Mail this copy to Board of Water Commissioners 429 Miss. St. Jackson, Miss.