

HINDS MISSISSIPPI BOARD OF WATER COMMISSIONERS

✓ 2021
1-10-66

WATER WELL DRILLERS LOG

Date: 1-10, 1966, Driller: HALL DRILLING Co County HINDS
(Name)

(1) Owner of Land: J.M. BUFKIN
(Name)
TERRY MISS
(Address)

(2) Location: NE 1/4, 1/4, Sec. 17 T3N R1W,
3 miles WEST of TERRY,
(distance) (direction) (Nearest Town)

(3) Topography: FLAT
(Hilly) (Flat) (Level)

(4) Purpose of Well: DOMESTIC Home
(Domestic Irrigation Municipal, Industrial, Other)

Description & Color of Materials Sand, Clay, Red Clay, Shell, etc.	Thick- ness Feet	Depth Feet
<u>SURFACE SOIL</u>	<u>3</u>	<u>3</u>
<u>WHITE MARL</u>	<u>20</u>	<u>23</u>
<u>ROCK LEDGES (LIME)</u>	<u>62</u>	<u>85</u>
<u>SAND + SHALE</u>	<u>64</u>	<u>149</u>
<u>SHALE</u>	<u>146</u>	<u>295</u>
<u>ROCK LEDGES</u>	<u>65</u>	<u>360</u>
<u>SAND + SEA SHELL</u>	<u>10</u>	<u>370</u>
<u>SAND + SHALE + LIENTS</u>	<u>35</u>	<u>405</u>
<u>SHALE</u>	<u>32</u>	<u>437</u>
<u>HARD ROCK</u>	<u>1</u>	<u>438</u>
<u>SHALE</u>	<u>6</u>	<u>444</u>
<u>COURSE SAND</u>	<u>16</u>	<u>460</u>


Information upon completion of well:

- (1) Diameter 4 X 2 inches. None
- (2) Total Depth 460' feet. ⁴⁶⁰/₁₀ = 450
- (3) Water Level 105 feet below top of ground.
- (4) Cased to 250' ^{700'}/_{650'}, Size 4" 2"
- (5) Screen: Size 2", Length 10'
- (6) Were any formations sealed against pollution?
_____ yes, no.

If YES depth of formation _____

Why _____

Drillers Remarks: _____

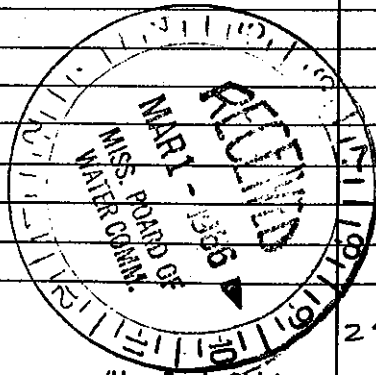

(Use Back Side)

Well No. 24

Mail this copy to Board of Water Commissioners 429 Miss. St. Jackson, Miss