


HINDS MISSISSIPPI BOARD OF WATER COMMISSIONERS

✓ 20204
4-22-66

WATER WELL DRILLERS LOG

Date: 4-22, 1966, Driller: James McNeess County Hinds
(Name)

		Description & Color of Materials Sand, Clay, Red Clay, Shell, etc.	Thick- ness Feet	Depth Feet
(1) Owner of Land: <u>E. Y. GUESS</u> (Name)		SURFACE SOIL	6	6
<u>Terry MISS</u> (Address)		SAND	37	43
(2) Location: <u>1/4, 1/4, Sec. 53 3N 1W</u>		Grey shale	20	63
<u>2</u> miles <u>West</u> of <u>Terry</u> (distance) (direction) (Nearest Town)		Grey shale sd strks	20	83
(3) Topography: <input checked="" type="checkbox"/> (Hilly) <input type="checkbox"/> (Flat) <input type="checkbox"/> (Level)		Grey sh	7	90
(4) Purpose of Well: <u>Domestic Home</u> (Domestic Irrigation, Municipal, Industrial, Other)		SAND	5	95
		Grey shale	60	155
		ROCK	1	156
		Grey shale	3	159
		ROCK SH STRKS	21	180
		SAND	8	188
		Grey shale	79	267
		LIME SH STRKS	30	297
		SAND	21	318
		shale	2	320
		SAND	4	324
		Grey shale	8	333
Information upon completion of well:				
(1) Diameter <u>4" x 2"</u> inches. Hole		13 Jts 4	273	
(2) Total Depth <u>333</u> feet.		1 4" x 2" SWEDGE	1	
(3) Water Level <u>150</u> feet below top of ground.			274	
(4) Cased to <u>297</u> well, Size <u>4" x 2"</u>		1-Jt 2"	21	
(5) Screen: Size <u>2.00?</u> , Length <u>20</u>		1-2"	2	
(6) Were any formations sealed against pollution? yes, <input checked="" type="checkbox"/> no, <input type="checkbox"/>			297	
If YES depth of formation _____		2-2" 002 SSS	20	
Why _____			317	
Drillers Remarks: _____		1-Jt 2" B.P.V.	8	
			325	

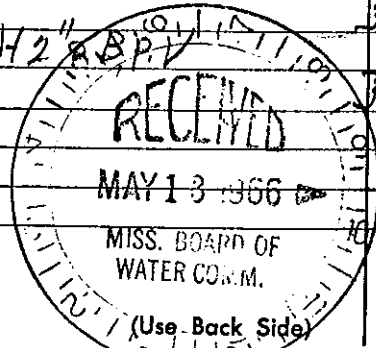

Well No.

Mail this copy to Board of Water Commissioners 429 Miss. St. Jackson, Miss.