

Hinds

V 2025

11-66

MISSISSIPPI BOARD OF WATER COMMISSIONERS

WATER WELL DRILLERS LOG


Date: November 30, 1966, Driller: Burney Water Well Service, Inc. Hinds

(1) Owner of Land: Bryant Stubbs (Name) Route 2 Terry (Address) (2) Location: NW 1/4, NW 1/4, Sec. 7, T3N, R1W, 5 miles West of Terry (3) Topography: Hilly (4) Purpose of Well: Domestic Home

Table with 3 columns: Description & Color of Materials, Thickness Feet, Depth Feet. Rows include: Yellow Buckshot & Clay, Blue Clay, Fine Blue sand, Blue clay, Layers of fine sand, Gumbo, Fine sand layers, Gumbo & Shale, Sand layers, Shale & Shell formations, Limestone & rock, Sand Layers & Shale, All fine sand, Layer of rock, Fine sand in layers, All fine sand, Shale.

Information upon completion of well:

(1) Diameter: 4 inches. (2) Total Depth: 386 feet. (3) Water Level: 71 feet below top of ground. (4) Cased to: 376, Size 2". (5) Screen: Size 2", Length 10'. (6) Were any formations sealed against pollution? X yes, no. If YES depth of formation: From Surface Why To prevent surface pollution Drillers Remarks: Well seal used Yield in gpm: 15 Size pump: 1 HP Type power: Electric

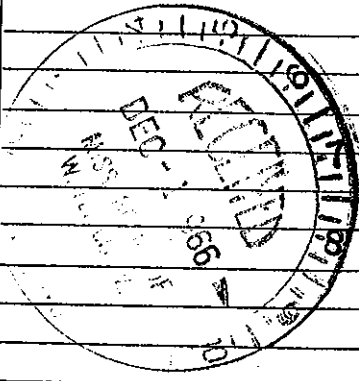

Mail this copy to Board of Water Commissioners 429 Miss. St. Jackson, Miss.