

HOLMES
A

MISSISSIPPI BOARD OF WATER COMMISSIONERS

8-20-57

WATER WELL DRILLERS LOG

C 332

Date: Aug. 20, 1957, Driller: Layne-Central Company County Holmes

(Name)

(1) Owner of Land: Egypt Planting Company

(Name)

Cruger, Mississippi

(Address)

Description & Color of Materials
Sand, Clay, Red Clay, Shell, etc.

Thick-
ness
Feet

Depth
Feet

Clay	16	16
Fine blue sand	8	24
Fine sand & clay balls	11	35
Coarse sand	7	42
Coarse sand & pea gravel	10	52
Sand & gravel	20	72
Coarse sand & gravel	10	82
Sand & pea gravel	20	102
Sand & big gravel	10	112

(2) Location: 1/4, 1/4, Sec. T. R.

5 miles north of Cruger
(distance) (direction) (Nearest Town)

(3) Topography: flat
(Hilly) (Flat) (Level)

(4) Purpose of Well: irrigation
(Domestic Irrigation
Municipal, Industrial, Other)

Information upon completion of well:

- (1) Diameter 16x12 inches.
- (2) Total Depth 112 feet.
- (3) Water Level 21'-4" feet below top of ground.
- (4) Cased to 60', Size 16"
2' swage
- (5) Screen: Size 12", Length 50'
- (6) Were any formations sealed against pollution?
 yes, no no.


If YES depth of formation

Why

Drillers Remarks:

1965 GPM

engine drive

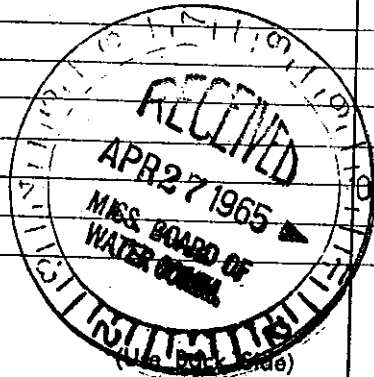

Well No.

Mail this copy to Board of Water Commissioners 429 Miss. St. Jackson, Miss