

MISSISSIPPI BOARD OF WATER COMMISSIONERS

HOLMES

A-306

WATER WELL DRILLERS LOG

7-5-60

Date: 7/5, 1960, Driller: Layne-Central Co. County Holmes

(Name)

Egypt Planting Co. (1) Owner of Land: J. T. Thomas (Name)	Description & Color of Materials Sand, Clay, Red Clay, Shell, etc.	Thick- ness Feet	Depth Feet
Cruger, Miss. (Address)	Clay	32	32
(2) Location: 1/4, 1/4, Sec. T R	Fine sand	18	50
2 miles North of Cruger (distance) (direction) (Nearest Town)	Blue clay	18	68
about 3 miles west of H. 49W	Coarse sand & gravel	37	105
(3) Topography: X (Hilly) (Flat) (Level)	Rock	0	105
(4) Purpose of Well: irrigation (Domestic Irrigation, Municipal, Industrial, Other)			


Information upon completion of well:

- (1) Diameter 18 inches.
- (2) Total Depth 105 feet.
- (3) Water Level 14'-9" feet below top of ground.
- (4) Cased to 65', Size 18"
- (5) Screen: Size 16", Length 40'
- (6) Were any formations sealed against pollution?  
yes, X no.

If YES depth of formation \_\_\_\_\_

Why \_\_\_\_\_

Drillers Remarks: \_\_\_\_\_

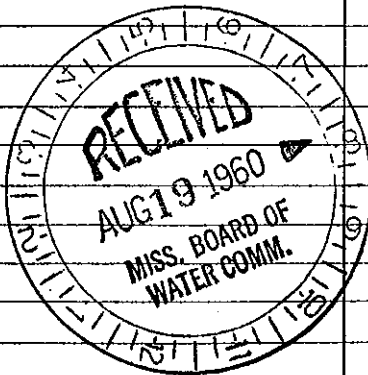

Well No.

(Use Back Side)

Mail this copy to Board of Water Commissioners 429 Miss. St. Jackson, Miss.