

Holmes  
A4  
5-67

MISSISSIPPI  
 BOARD OF WATER COMMISSIONERS  
 416 North State Street  
 Jackson, Mississippi

8/24/67  
 2448  
 well #1

WATER WELL DRILLERS LOG

May 4, 19 67 Layne-Central Company Holmes  
 date well completed firm name county well located

LANDOWNER: R. T. Hardeman  
 Cruger, Mississippi  
 (mailing address)


description of formations encountered	from	to
Clay	0	17
Fine sand	17	35
Coarse sand	35	55
Coarse sand, pea gravel	55	88
Coarse sand, gravel	88	110
Cemented gravel	110	112

WELL LOCATION: SW 1/4 NE 1/4 NE 1/4 SE  
 sec 27 T 17 N R 1 E W  
 5 miles southwest of Cruger  
 (distance) (direction) (nearest town)

WELL PURPOSE: irrigation  
 (home, irrigation, municipal, industrial)

CODED

- WELL COMPLETION DATA:
- diameter (inches) 16
  - total depth (feet) 112
  - static water level (feet) 19 ~~XXXXXX~~ above top of ground.
  - casing Steel, 62' (material) (depth)  
 16" (size) if telescope see back.
  - screen 50' 112' (length) (depth to top)  
 16" Armco (size) (material)
  - pump 50 2000 (HP) (yield gpm)  
 engine (type power)
  - electric log no (yes or no)  
 (organization running log)
  - how well bottom plugged plate

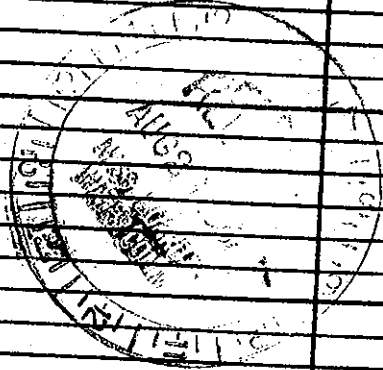

DRILLERS REMARKS: