

MISSISSIPPI  
BOARD OF WATER COMMISSIONERS  
416 North State Street  
Jackson, Mississippi 39201

WATER WELL DRILLERS LOG

CODED

Holmes  
A 5  
5-67

May 19, 1967 date well completed  
BUTANE GAS Co. of Greenwood firm name  
Holmes county well located

LANDOWNER: James W. Long

RT. 2

CRUGER Miss  
(mailing address)

WELL LOCATION:

sec. 32 T. 19 N R. 1 W

5 miles W of CRUGER  
(distance) (direction) (nearest town)

WELL PURPOSE:  
(home, irrigation, municipal, industrial)


WELL COMPLETION DATA:

- (1) diameter (inches) 12"
- (2) total depth (feet) 103 CODED
- (3) static water level (feet) 16 below top of ground
- (4) casing BLACK 63'  
(material) (depth)  
12" if telescope see back.  
(size)
- (5) screen 40' 63'  
(length) (depth to top)  
12 BLANK STEEL  
(size) (material)
- (6) pump 40 2,000  
(HP) (yield gpm)  
L.P.G.  
(type power)
- (7) electric log No  
(yes or no)
- (organization running log)
- (8) how well bottom plugged  
STEEL PLATE

description of formations encountered

from to

TOP SOIL	0	4
RED SAND	4	20
FINE SAND & GRAVEL	20	60
COARSE SAND & GRAVEL	60	103

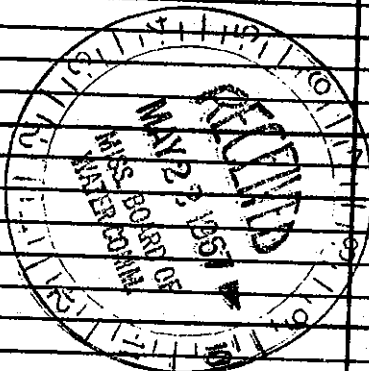

DRILLERS REMARKS: