

2 Holmes
~~20~~ A 7
 5-67

MISSISSIPPI
 BOARD OF WATER COMMISSIONERS
 416 North State Street
 Jackson, Mississippi 39201

8/24/67
 CODED
 2448
 Well # 2

WATER WELL DRILLERS LOG

May 12, 1967 Layne-Central Company Holmes
 date well completed firm name county well located

LANDOWNER: R. T. Hardeman

Cruger, Mississippi

(mailing address)

WELL LOCATION: NE 1/4 NE 1/4

sec. 33 T. 17 N R. 1 E

5 1/2 miles southwest Cruger
 (distance) (direction) (nearest town)


WELL PURPOSE: irrigation
 (home, irrigation, municipal, industrial)

WELL COMPLETION DATA:

- (1) diameter (inches) 12
- (2) total depth (feet) 108
- (3) static water level (feet) 15' 2" above
 top of ground.
- (4) casing steel 78'
 (material) (depth)
 12" if telescope see back.
 (size)
- (5) screen 30' 108'
 (length) (depth to top)
 12" Armc
 (size) (material)
- (6) pump 30 1200
 (HP) (yield gpm)
 engine
 (type power)
- (7) electric log no
 (yes or no)
 (organization running log)
- (8) how well bottom plugged plate

description of formations encountered	from	to
Clay	0	16
Fine sand	16	26
Coarse sand	26	55
Coarse sand, pea gravel	55	68
Clay balls, coarse sand, pea gravel	68	70
Coarse sand, gravel	70	108

CODED

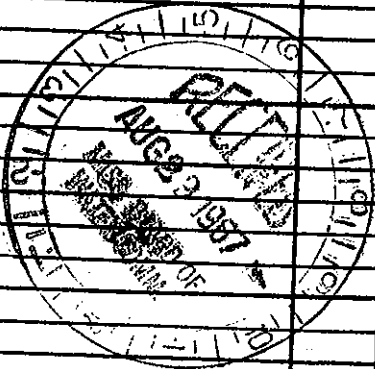

DRILLERS REMARKS: