


HOLMES
B16
7-63

MISSISSIPPI BOARD OF WATER COMMISSIONERS

WATER WELL DRILLERS LOG CODED

Date: July, 1963, Driller: Jack Martin County Holmes
(Name)

(1) Owner of Land:	Description & Color of Materials Sand, Clay, Red Clay, Shell, etc.	Thick- ness Feet	Depth Feet
<u>Ja. Rathliff</u> (Name)	<u>Top clay</u>	<u>16</u>	<u>16</u>
<u>Cruzer Miss</u> (Address)	<u>Sand - mud</u>	<u>20</u>	<u>36</u>
(2) Location: <u>SW 1/4, SW 1/4, Sec. 24 T17R1E</u>	<u>Hard pan</u>	<u>1</u>	<u>37</u>
<u>7</u> miles <u>East</u> , of <u>Cruzer</u> (distance) (direction) (Nearest Town)	<u>Sand</u>	<u>23</u>	<u>60</u>
(3) Topography: <u>Hilly</u> (Hilly) (Flat) (Level)	<u>Mud</u>	<u>8</u>	<u>68</u>
(4) Purpose of Well: <u>Domestic</u> (Domestic Irrigation Municipal, Industrial, Other)	<u>Sand & mud</u>	<u>13</u>	<u>81</u>
Information upon completion of well: <u>CODED</u>	<u>Pipe clay</u>	<u>71</u>	<u>152</u>
(1) Diameter <u>2</u> inches.	<u>Sand</u>	<u>60</u>	<u>212</u>
(2) Total Depth <u>600</u> feet.	<u>Mud</u>	<u>56</u>	<u>268</u>
(3) Water Level <u>16</u> feet below top of ground.	<u>layers (sand - mud)</u>	<u>42</u>	<u>310</u>
(4) Cased to <u>580</u> , Size <u>2</u>	<u>Sand</u>	<u>26</u>	<u>336</u>
(5) Screen: Size <u>2</u> , Length <u>20</u>	<u>Mud</u>	<u>146</u>	<u>482</u>
(6) Were any formations sealed against pollution? _____ yes, _____ no.	<u>Rock layers</u>	<u>4</u>	<u>486</u>
If YES depth of formation _____	<u>mud</u>	<u>21</u>	<u>507</u>
Why _____	<u>rock</u>	<u>2</u>	<u>509</u>
Drillers Remarks: _____	<u>shale - mud</u>	<u>26</u>	<u>535</u>
_____	<u>shale - sand</u>	<u>40</u>	<u>575</u>
_____	<u>sand</u>	<u>28</u>	<u>600</u>

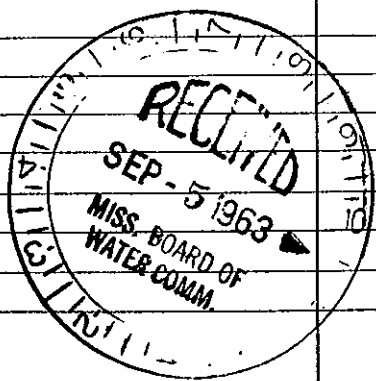

Well No.

(Use Back Side)

Mail this copy to Board of Water Commissioners 429 Miss. St. Jackson, Miss.