

**MISSISSIPPI DEPARTMENT OF NATURAL RESOURCES**  
Bureau of Land and Water Resources

P.O. Box 10631  
Jackson, Mississippi 39209  
**WATER WELL DRILLERS LOG**

149

COUNTY WELL LOCATED <i>Holmes</i>	
WELL NUMBER <i>B 26</i>	CODED
DATE WELL COMPLETED <i>5-29-89</i>	

PERMIT NUMBER <b>CODED</b>
NAME OF DRILLING FIRM <i>Butane Gas Co.</i>

NAME & MAILING ADDRESS OF LANDOWNER <i>Pinchback Farms 40 Fisher Farm Drive P.O. Box 926 Aberdeen Ms. 39730</i>		
WELL LOCATION: SEC	TOWNSHIP	RANGE
<i>28</i>	<i>17<sup>S</sup></i>	<i>1<sup>W</sup></i>
DISTANCE	DIRECTION	NEAREST TOWN
<i>3</i> Miles	<i>E</i>	<i>Cragg</i>
OTHER LANDMARK		
WELL PURPOSE: Home, Irrigation, Municipal, Industrial, Fish Pond, etc. <i>Irrig Pivot</i>		

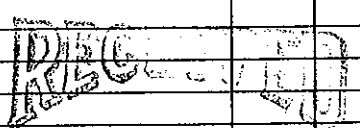
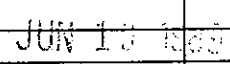
PUMP DATA		
PUMP TYPE (Circle One): Submersible, <u>Turbine</u> , Jet, Flowing Well, Other (Describe)		
POWER TYPE (Circle One): Electric, Tractor, <u>Diesel</u> , Gasoline, Butane, Other (Describe) H/P <u>130</u>		
Pump Capacity (GPM) <i>1200</i>	No. of Stages <i>3</i>	Setting Depth <i>60'</i> FT.
PUMP TEST		
Well yielded <u>1200</u> GPM with a drawdown of <u>8</u> ft. after <u>2</u> hours of pumping		

WELL DATA		
Well Depth <i>100</i>	Casing Diameter (In.) <i>16"</i>	Casing Length (Ft.) <i>60</i>
Type of Casing <i>Steel</i>	Hole Depth <i>100</i>	Depth to Static Water Level <i>14'</i>
TYPE OF COMPLETION: (Circle One or More): <u>Gravel Packed</u> , Underreamed, Telescoped, Natural Development, Open Hole, Other		
Top of Lap Pipe or Reduction in Casing		
FEET	IF TELESCOPED OR MORE THAN ONE SCREEN: USE BACK PAGE	

LOG DATA	
TYPE OF LOG RUN (Circle One): Electric, Gamma Ray, Density, Sonic, Neutron, Other (Describe) <u>No Log Run</u>	
Name of Organization Running Log	

SCREEN DATA		
Diameter - Inches <i>16"</i>	Length - Feet <i>40'</i>	Slot Size - Inches <i>30T</i>
Screen Type <i>Wire wrap</i>	Depth to Bottom - Feet <i>100</i>	

GEOLOGIC DATA (Office Use Only)			
Surface Elev.	Geologic Unit	Unit Thickness	Depth to Top
Subs. SWL	Date	Analysis	Aquifer Test
Driller's Remarks			

DESCRIPTION OF FORMATIONS ENCOUNTERED	FROM	TO	FORMATIONS (Continued)	FROM	TO
<i>Clay</i>	<i>1</i>	<i>21</i>	  Department of Natural Resources Bureau of Land & Water Resources		
<i>fine sand + clay</i>	<i>21</i>	<i>34</i>			
<i>fine sand</i>	<i>34</i>	<i>46</i>			
<i>coarse sand</i>	<i>46</i>	<i>88</i>			
<i>coarse sand + gravel</i>	<i>88</i>	<i>100</i>			

IF MORE SPACE IS NEEDED, USE BACK