
Jun	ell Report	······································
Cturty Holmes P	art 1	For Office Use Only:
Au 29922 Mississippi Departmen	t of Environmental Quality	Aquifer:
Trrightion Equipment	nd Water Resources lox 10631	Well #: <u>B-36</u>
	IS 39289-0631	L. S. Elevation:
	961-5210	E-log #:
(601)35	4-6938 (fax)	E-log #:
State Law requires that this report be prepared by the 30 days of completion of drilling of the well.	driller in detail and filed w	ith the Department within
Well Owner Information	Wel	Location
Owner Name Egypt Planting Company	Latitude:19 , 11	^N Longitude: 90 . 12, 17W,
Mailing Address: 2315 Egypt Road	Method of Lat/Long (circle or	ne): Conventional Survey,
	USGS quad, Hand-held	GPS, Survey-grade GPS
Cruger, MS 38924	NE SW 16 Sm 21	
City State Zip Code		
Telephone No. ()	Distance Direction <u>2</u> Miles East	of Cruger
Well	Dete	
	\bigcirc	Replacement
Purpose of Well (circle one) Home Industrial Public Supply		
Date well drilling started: $1-26-05$ Date	well drilling completed:	26-05
If flowing, method of flow regulation: Valve Other (describe)	
Static Water Level:feet above or below (circle one)	land surface Date measured:	
Method of Measurement (circle one) steel tape electric tap	e air line other:	
Hole depth: 126 ' Well depth: 126 '		
	_ well grouted to a deput of	ICC1
Type of grout (circle one): Cement Bentonite Mix		
Casing length: 86 feet Casing diameter: 16	inches Type of casing:	PVC Sch.40
Screen length:feet Screen diameter:16	inches Type of screen:	PVC Sch.40
Screen slot size: <u>.050</u> inches Setting depth: From	87	126feet
Type of completion (circle all applicable): Gravel packed Und	areamed Telescoped Ope	n hole Natural Development
Other (describe):		
Other (describe):	•	
• • •	•	reen, describe on back of page
	telescoped or more than one so	reen, describe on back of page
Top of lap pipe or reduction in casing:feet. If Logs run (circle all applicable): No log run Electric Gamma Ra	telescoped or more than one so y Density Sonic Neutron	reen, describe on back of page Other:
Top of lap pipe or reduction in casing:feet. If Logs run (circle all applicable): No log run Electric Gamma Ra Name of organization running log(s): I certify that the well was drilled, constructed, and completed in	telescoped or more than one so y Density Sonic Neutron accordance with all applicable	creen, describe on back of page Other: e requirements of the Mississippi
Top of lap pipe or reduction in casing:feet. If Logs run (circle all applicable): No log run Electric Gamma Ra	telescoped or more than one so y Density Sonic Neutron accordance with all applicable	creen, describe on back of page Other: e requirements of the Mississippi
Top of lap pipe or reduction in casing:feet. If Logs run (circle all applicable): No log run Electric Gamma Ra Name of organization running log(s): I certify that the well was drilled, constructed, and completed in Department of Environmental Quality and/or the Mississippi D	telescoped or more than one so y Density Sonic Neutron accordance with all applicable	creen, describe on back of page Other: e requirements of the Mississippi
Top of lap pipe or reduction in casing:feet. If Logs run (circle all applicable): No log run Electric Gamma Ra Name of organization running log(s): I certify that the well was drilled, constructed, and completed in Department of Environmental Quality and/or the Mississippi D Irrigation Equipment Inc.	telescoped or more than one so y Density Sonic Neutron accordance with all applicable epartment of Health regulation Patuch	creen, describe on back of page Other:
Top of lap pipe or reduction in casing:feet. If Logs run (circle all applicable): No log run Electric Gamma Ra Name of organization running log(s): I certify that the well was drilled, constructed, and completed in Department of Environmental Quality and/or the Mississippi D Irrigation Equipment Inc. Patrick M. Chism 0695	telescoped or more than one so y Density Sonic Neutron accordance with all applicable epartment of Health regulation Patuch	creen, describe on back of page Other:
Top of lap pipe or reduction in casing:feet. If Logs run (circle all applicable): No log run Electric Gamma Ra Name of organization running log(s): I certify that the well was drilled, constructed, and completed in Department of Environmental Quality and/or the Mississippi D Irrigation Equipment Inc. Patrick M. Chism 0695	telescoped or more than one so y Density Sonic Neutron accordance with all applicable epartment of Health regulation Patuch	creen, describe on back of page Other:

If well telescopes please sketch below and show depths.

Ground Level

Description of Formations Encountered	From	To 1
Clay .	0	18
Fine Sand	119	5.5
Fine Sand/gravel Med. Sand/gravel	56	65
Med. Sand/gravel	66	126
· · · · · · · · · · · · · · · · · · ·		
·		
· · · · · · · · · · · · · · · · · · ·		
		11
		<u> </u>

If more than one screen, show location of each on sketch

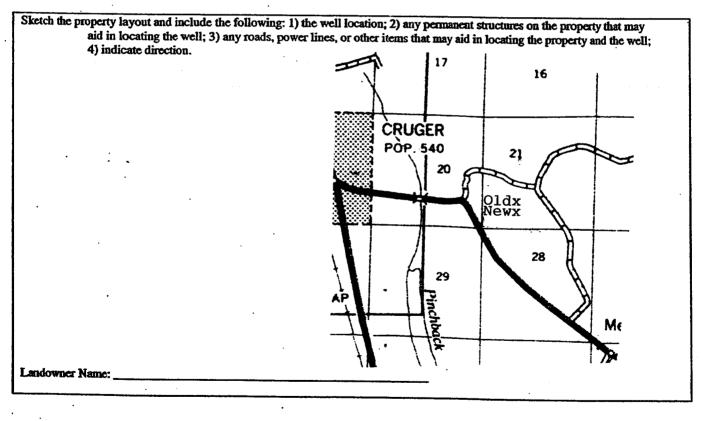

Signature of Water Well Contractor

County: Holmes	STATE WELL REPORT Part 2 Pump Installer's Completion Report Mississippi Department of Environmental Quality Office of Land and Water Resources P.O. Box 10631 Jackson, MS 39289-0631 (601)961-5210 (601)354-6938 (fax)		For Office Use Only: Aquifer:
Permit #: Irrigation Equipment Driller:			Well #: <u>B-36</u>
Date completed:5-11-05			
This report should be prepared by a installation of pump.	the pump installer in det	ail and filed with the Departmo	ent within 30 days of the
Well Owner Informa	ition	We	l Location
Owner Name: Egypt Plant	ing Company	ing Company Latitude:	
Mailing Address: 2315 Egypt	Road	Method of Lat/Long (circle or	ne): Conventional Survey,
		USGS auad. Hand	I-heid GPS, Survey-grade GPS
Cruger MC	38924	1 · · ·	17N 1E TwnRng
Cruger, MS City State	Zip Code		
			Nearest Town
Telephone No. ()		Mileso	f_Cruger
Ритр Туре		Pa	wer Type
Circle one			ircle one
Air Lift Jet	Submersible	Diesel Engine Gasolin	ne Engine Natural Gas
Bucket Piston	Turbine	Electric Motor Hand	Tractor PTC
Centrifugal Rotary	Flowing Well	Windmill Other	(specify):
Other (specify):		Horse Power Rating of Motor	. 60
Date Pump Installed: $5-11-05$		Setting Depth:60	feet
2500-300 Rated Pump Capacity:	0 _Gallons Per Minute	Number of Stages:1	
Pump Test Data			asuring Water Level ircle one
Date Well Tested:			
Static Water Level (A):Fee	t Below Land Surface		suring Line Steel Tape
Pumping Water Level (B):Feet	t Below Land Surface	Other (specify):	
Drawdown [(B) - (A)]:Fee	t Below Land Surface	For flowing well, measured sl	nut in head:feet
Test Pumping Rate:	_Gallons Per Minute	Well yielded	GPM with a drawdown of
Duration of Pump Test (minimum 4 hours):hours	feet after	hours of pumping

Part 1 Well Log Was Mailed Feb. 05. Copy of Part 1 is attached. Part 2 Completed 5-11-05.

RECEIVED MAY 3 + 2005 BY OLWR