

HOLMES
B 2000
5-31-65

WATER WELL DRILLERS LOG

Date: MAY 31, 1965, Driller: DELTA DRILLING Co. County HOLMES
(Name)

(1) Owner of Land: D. G. GRIFFIN
(Name)

CRUGER, MISS.
(Address) 45 16 1E
33 17 1E

(2) Location: 1/4, 1/4, Sec. T R

 miles of
(distance) (direction) (Nearest Town)

(3) Topography:
(Hilly) (Flat) (Level)

(4) Purpose of Well: DOMESTIC HOM.
(Domestic Irrigation, Municipal, Industrial, Other)

Information upon completion of well:

(1) Diameter 3 inches.

(2) Total Depth 1004 feet.

(3) Water Level Flows feet below top of ground.

(4) Cased to 984, Size 3" 509', 2" 524'

(5) Screen: Size 2", Length 20'

(6) Were any formations sealed against pollution?


 yes, no. 984
20

If YES depth of formation 1004

Why

Drillers Remarks: 29" LAP OF 2" PIPE
IN 3" PIPE

Description & Color of Materials Sand, Clay, Red Clay, Shell, etc.	Thick- ness Feet	Depth Feet
SAND	59	59
GRAVEL	62	121
SAND	120	241
GUMBO	22	263
SAND	99	362
SHALE	20	382
SAND	65	447
SHALE	25	472
GUMBO	112	584
SHALE W/ROCKS	26	610
GREEN SAND	22	632
SHALE	26	658
SAND W/ROCKS	10	668
GUMBO	22	690
SAND	30	720
GUMBO	24	744
SAND	10	754
GUMBO	16	770
SHALE W/ROCKS	42	812
SAND	36	854
SHALE	16	870
SAND	124	1004

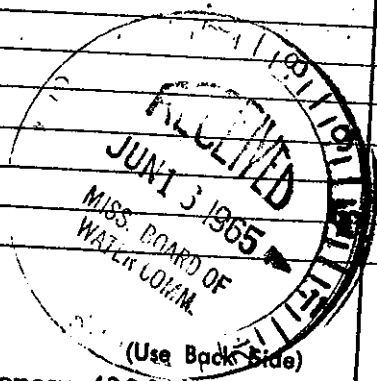

Well No. _____

Mail this copy to Board of Water Commissioners 429 Miss. St. Jackson, Miss.