

4

C
5-63

WATER WELL DRILLERS LOG

Date: May, 1963, Driller: Back Mountain county Holmes
(Name)

(1) Owner of Land:	Description & Color of Materials Sand, Clay, Red Clay, Shell, etc.	Thick- ness Feet	Depth Feet
<u>B.L. Bruce</u> (Name) <u>Lexington</u> (Address)	<u>Top clay</u>	<u>32</u>	<u>32</u>
(2) Location: <u>1/4</u> , <u>1/4</u> , Sec. <u>T</u> <u>R</u> <u>6</u> miles <u>SW</u> of <u>Black Mt</u> (distance) (direction) (Nearest Town)	<u>Sand</u>	<u>70</u>	<u>102</u>
(3) Topography: <u>Hilly</u> (Hilly) (Flat) (Level)	<u>Gravel</u>	<u>16</u>	<u>118</u>
(4) Purpose of Well: <u>Domestic</u> (Domestic Irrigation Municipal, Industrial, Other)	<u>Mud</u>	<u>40</u>	<u>158</u>
	<u>Sand</u>	<u>42</u>	<u>200</u>


Information upon completion of well:

- (1) Diameter 2 inches.
- (2) Total Depth 200 feet.
- (3) Water Level 124 feet below top of ground.
- (4) Cased to 195, Size 2
- (5) Screen: Size 2, Length 5
- (6) Were any formations sealed against pollution?
_____ yes, _____ no.

If YES depth of formation _____

Why _____

Drillers Remarks: _____

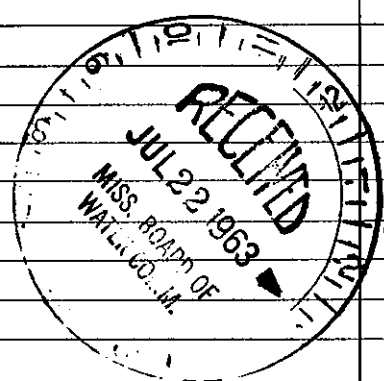

(Use Back Side)

Well No.